


# T. 4 S., R. 10 W., W.M.

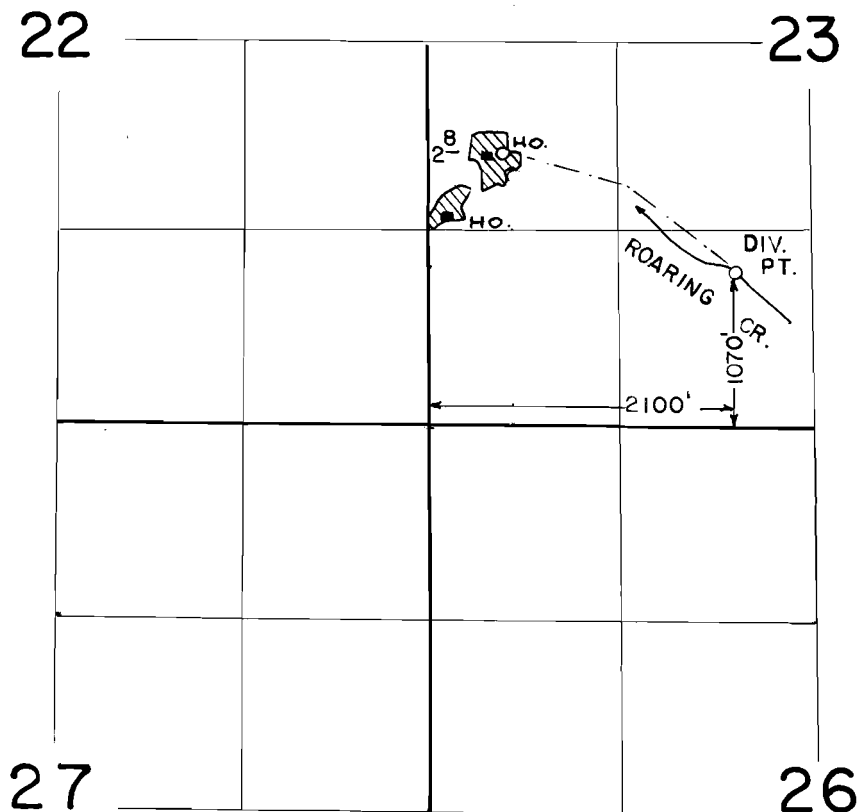

SCALE  
1" = 1320'

## FINAL PROOF SURVEY UNDER

Application No. 59782 Permit No. 46175  
IN NAME OF

MR. MERT LOUCKS & MR. JACK COLWELL

Surveyed AUG 2 1984, by P. PAGTER