


T. 36S., R. 14 W., W. M.

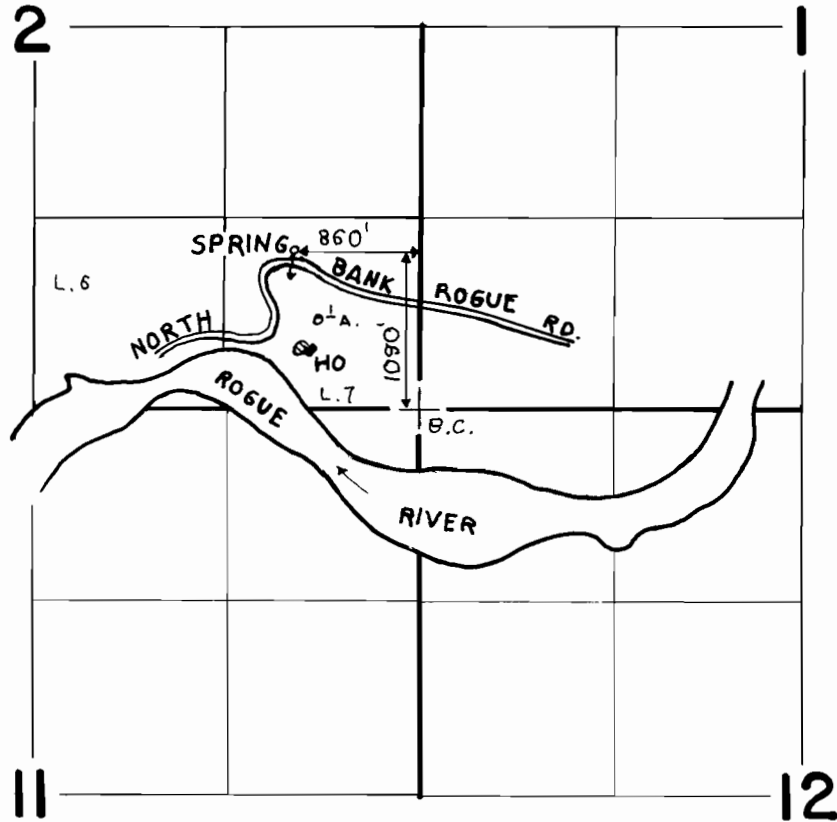

SCALE: 4" = 1 MILE

FINAL PROOF SURVEY UNDER

Application No. 61872... Permit No. 46252...
IN NAME OF

JACK C. MACE

Surveyed SEPT. 24 1986, by J. M. SCHMORDE