


Application No. 61945
Permit No. 46279

RECEIVED
JUL 23 1981
WATER RESOURCES DEPT
SALEM, OREGON

T4S. R9W. WM.

RECEIVED
DEC 24 1981
WATER RESOURCES DEPT
SALEM, OREGON

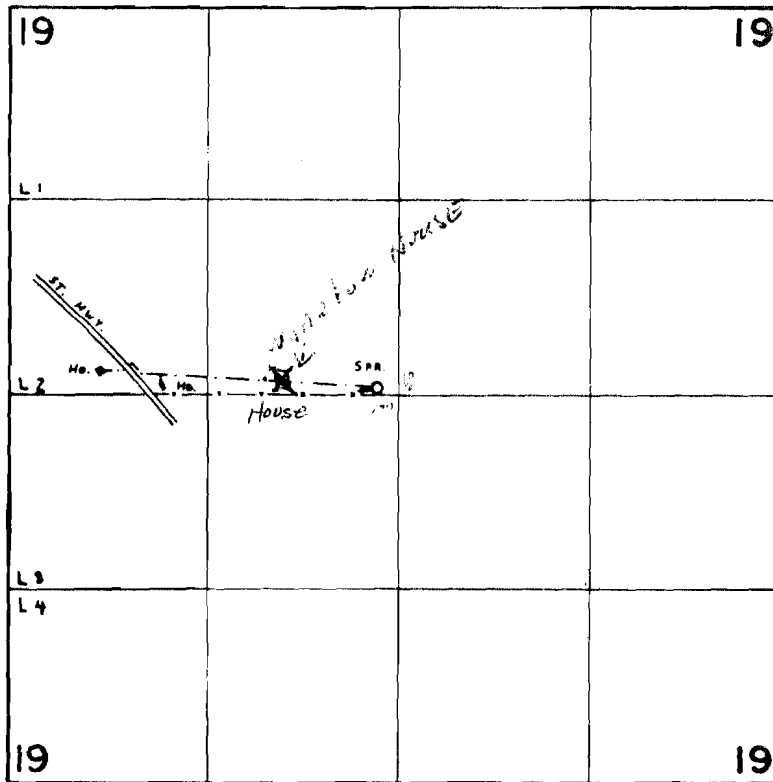

~~S.P.A. Loc. 50 N. 2520 E. fr. W 1/4 Cor. SEC. 19.~~

FINAL PROOF SURVEY
UNDER

Application No. 49127 Permit No. 36838
IN NAME OF

William Beene & Debra Perry

Surveyed SEPT. 13 1978, by C. L. HUGHES