


T. 37 S., R. 3 E., W.M.

Sec. 4

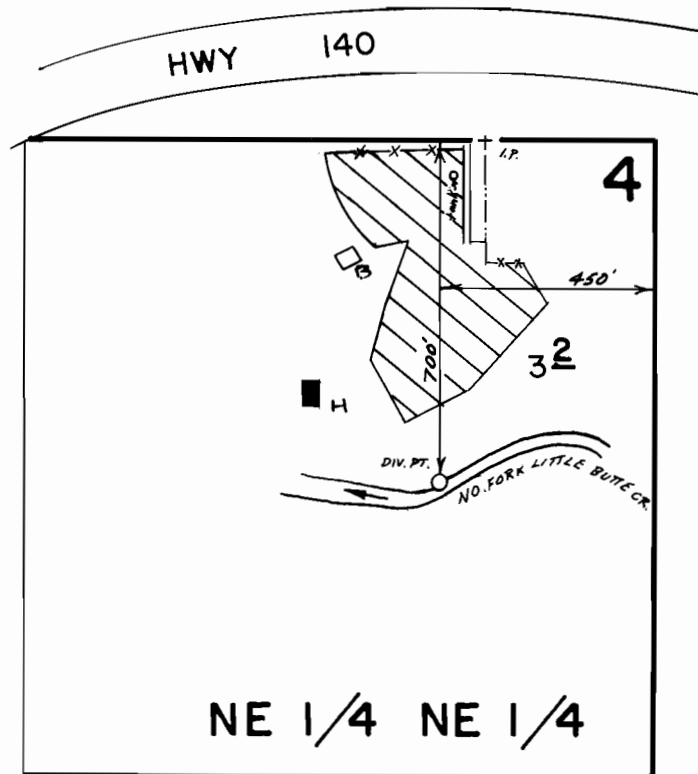

Scale 1" = 400'

FINAL PROOF SURVEY
UNDER

Application No. 64500 Permit No. 47228
IN NAME OF

MRS. JAMES O. LYON

Surveyed Aug. 5, 1986, by B.S. JAMES