T. 3S., R. 9W. W.M.

SCALE 1" = 400'

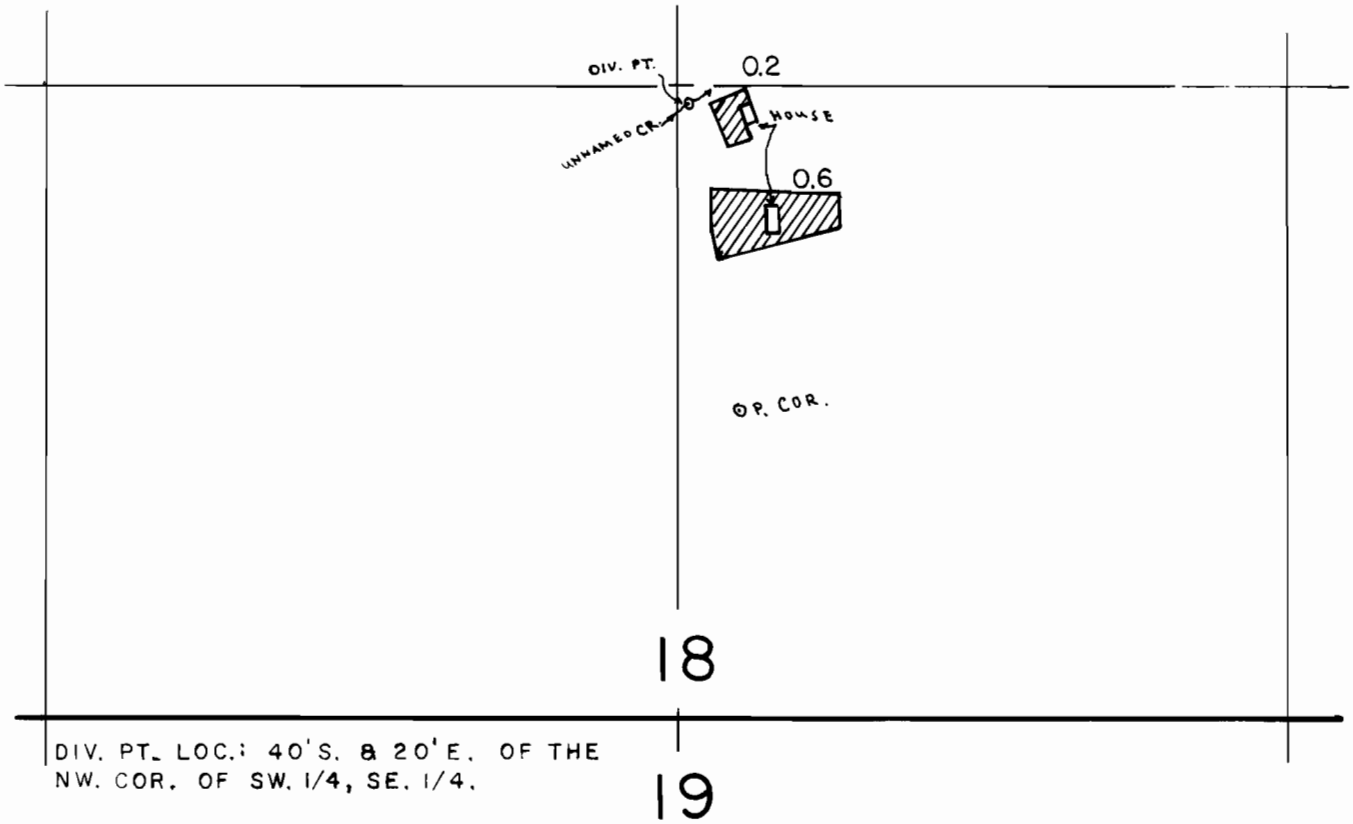

DIV. PT. LOC.: 40'S. & 20'E. OF THE NW. COR. OF SW. 1/4, SE. 1/4.

FINAL PROOF SURVEY
UNDER

Application No. 64963 Permit No. 47442
IN NAME OF

ROY L. JONES

Surveyed OCT. 13. 1983, by PAGTER, P.

PTS 1983AA PGT