


T. 19 S., R. 12 W., WM.

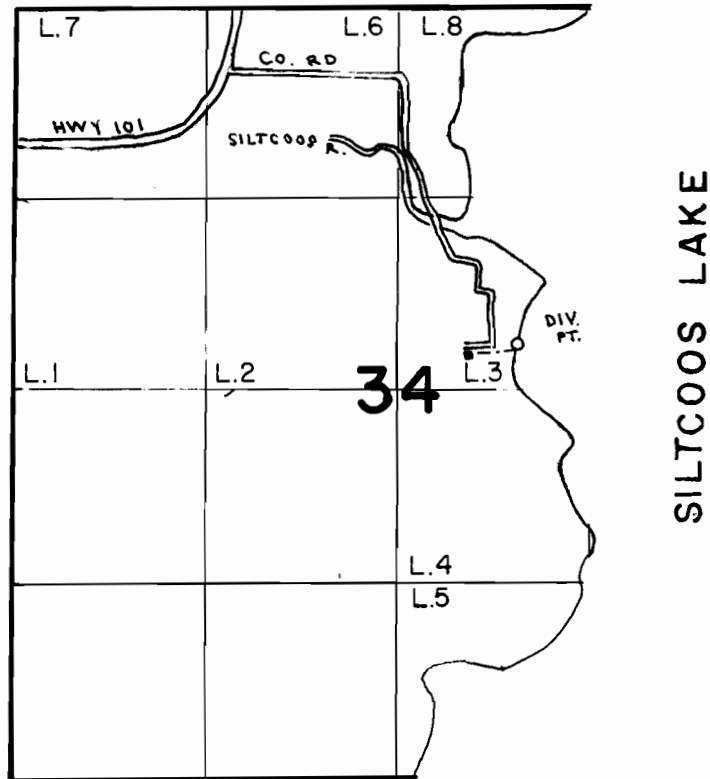

DIV. PT. LOC.: 2300' S. & 3440' E. OF NW. COR. SEC. 34

**FINAL PROOF SURVEY**  
UNDER

Application No. 64770. Permit No. 47478  
IN NAME OF

LOUISE M. NORDAHL

Surveyed NOV. 4 1983, by P. PAGTER