


T. 13S., R. 9E., W.M.

SECTION 15

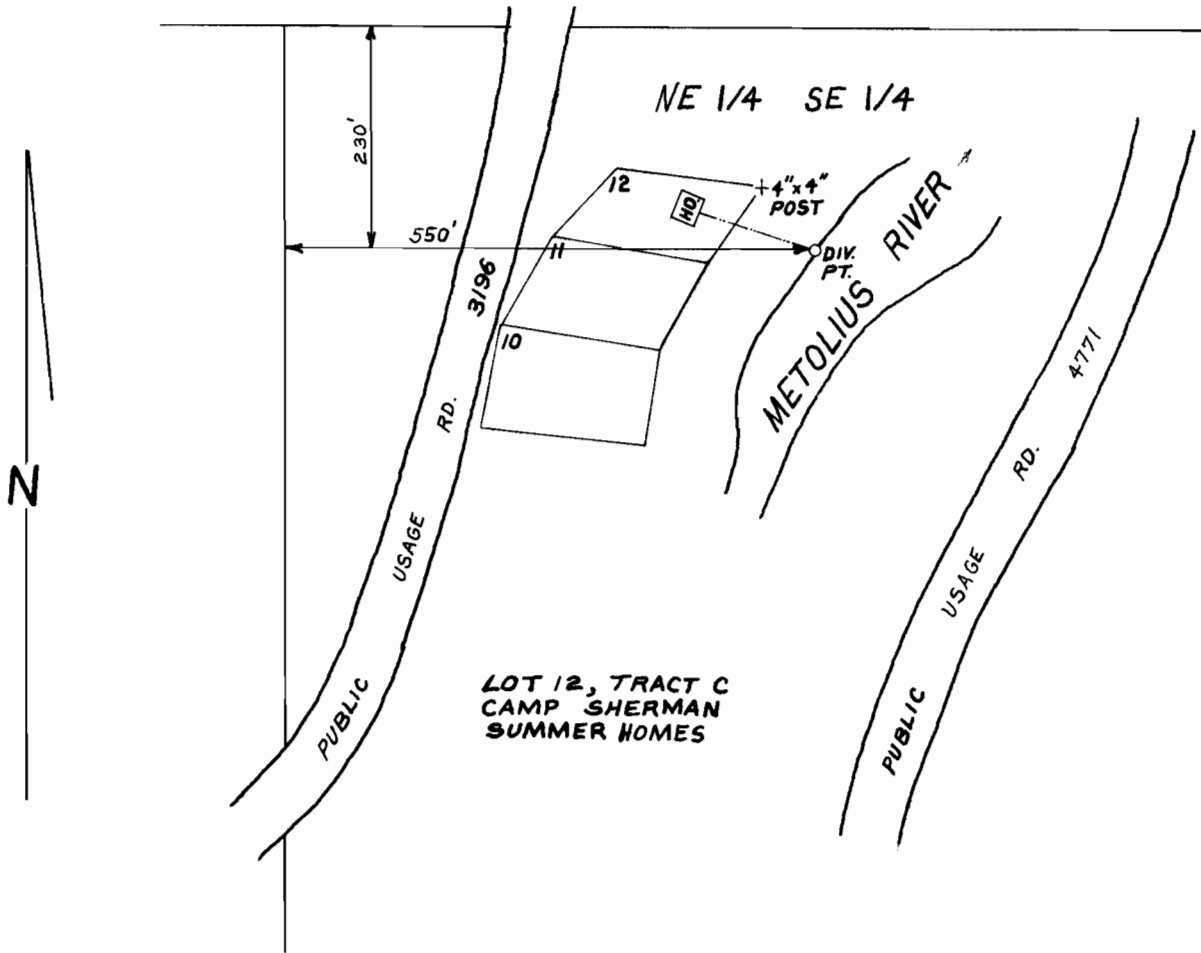

SCALE: 1" = 200'

FINAL PROOF SURVEY

UNDER

Application No. 65469 Permit No. 47957

IN NAME OF

PETE F. LEITHAUSER

Surveyed APRIL 3 19 85, by LESLIE OLSON