


T. 13 S., R. 9 E., W. M.

SECTION 15

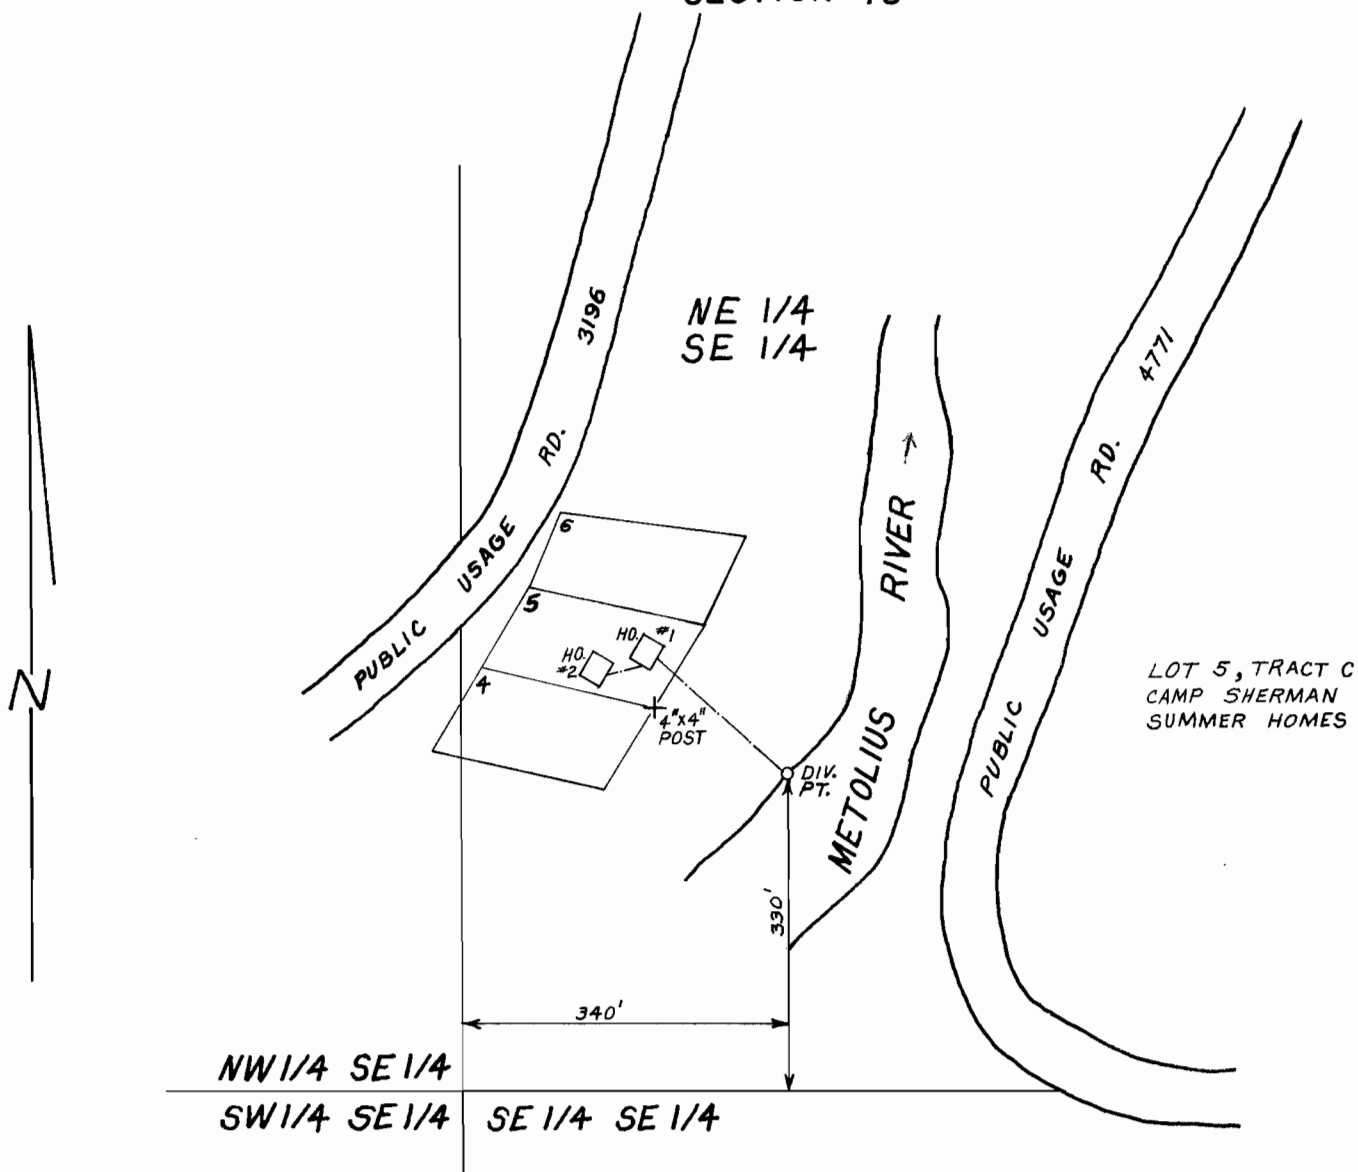

SCALE: 1" = 200'

FINAL PROOF SURVEY

UNDER

Application No. 65513 Permit No. 47982

IN NAME OF

RONALD W. KUNZMAN

Surveyed APRIL 3, 1985, by LESLIE OLSON

CHAIN & COMPASS SURVEY *tbl*