


T. 3 S. R. 1 W. W. M.

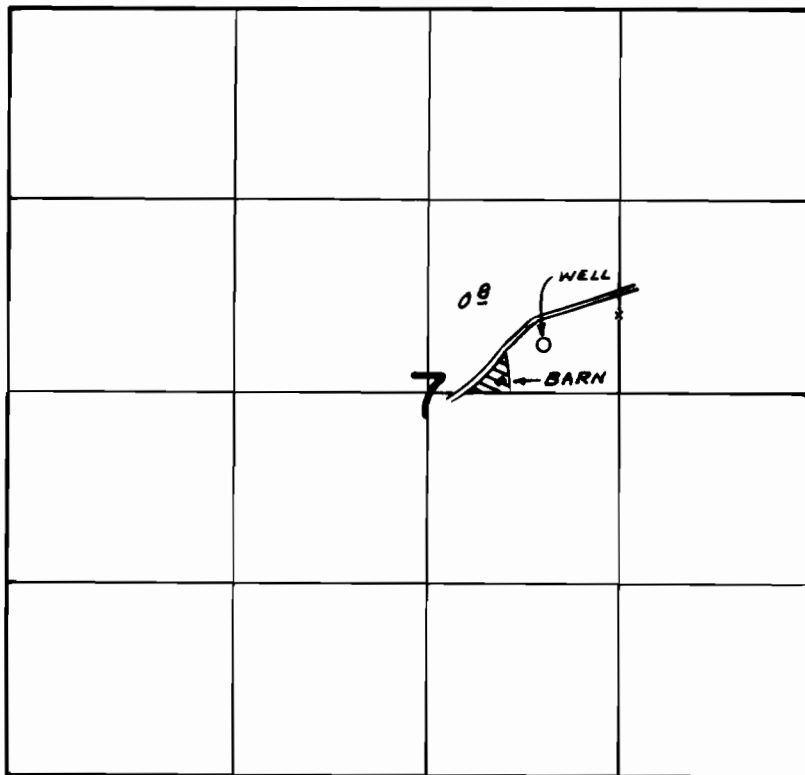

WELL LOC: 330' N. & 520' W. FROM S.E. COR. SW $\frac{1}{4}$ NE $\frac{1}{4}$ SEC. 7

FINAL PROOF SURVEY

UNDER

Application No. *G-3119*. Permit No. *G-2926*.
IN NAME OF

...BENJAMIN E. & JACQUELINE... HINKLE

Surveyed *JAN. 17*, 19*80*, by *R. G. MURKIN*