


T. 26 S., R. 4 W., W.M.

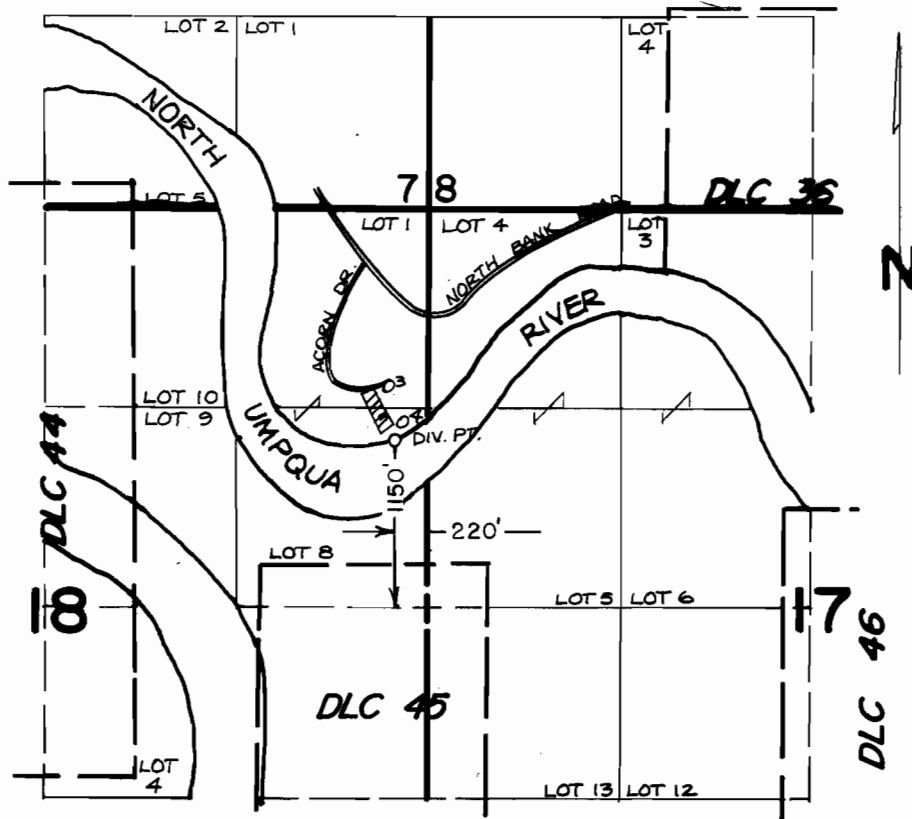

SCALE: 4" = 1 MILE

FINAL PROOF SURVEY UNDER

Application No. ...68432 Permit No.49417
IN NAME OF

.....**JOE A. FOLSOM**.....

Surveyed ..SEPT..9, 19.86, by ...J.M..SCHMORDE