

SEC. 3 T18S R12E W M

DESCHUTES COUNTY

SCALE 1" = 400'

cont. 57054  
insp. 1118 families  
NE 1/4 NW  
SW 1/4 NW  
SE 1/4 NW

33 | 34

34


4 | 3

city of  
Bend

NE 1/4 NW 1/4

SW 1/4 NW 1/4

SE 1/4 NW 1/4

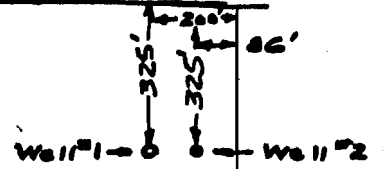

**RECEIVED**  
MAY 21 1969  
STATE ENGINEER  
SALEM OREGON

Application No. G 4887  
Permit No. G 4608