


T. 39 S., R. 1 E., W. M.

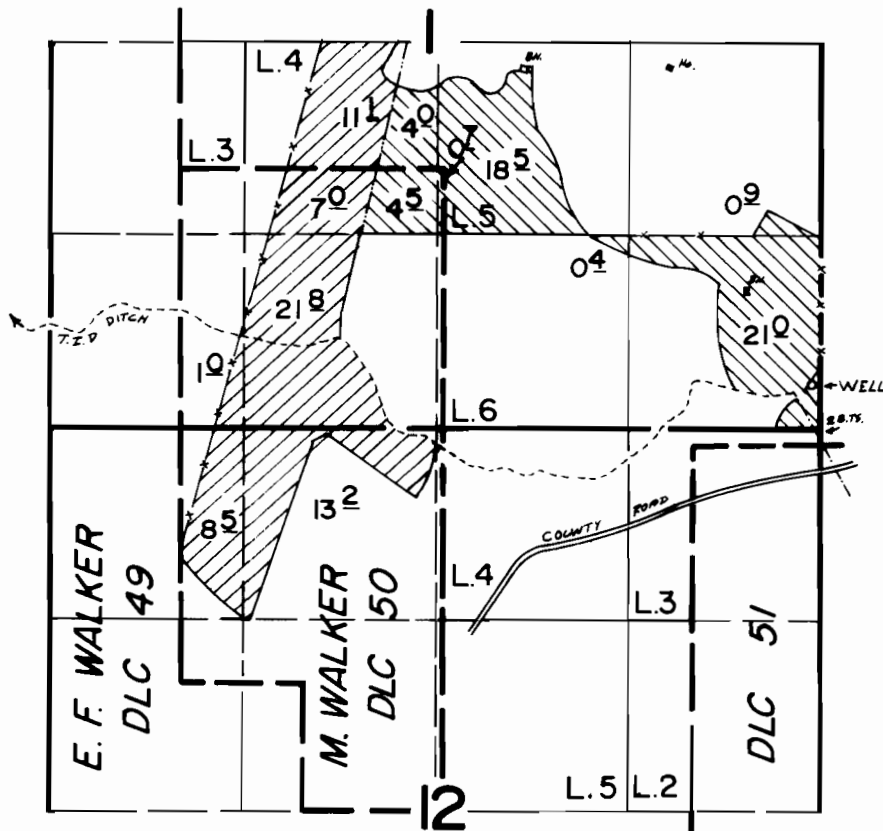

Well = 300' N & 60' W from SE Cor. Sec. 1.

SCALE 4" = 1 Mile

FINAL PROOF SURVEY UNDER

G-6543 G-6148 

Application No. G-6192. Permit No. G-5220 

IN NAME OF

..... WALLACE SHAFFER

Surveyed JUNE 7, 1984, by BS JAMES