


**T.37 & 38S. R.4W. W. M.**

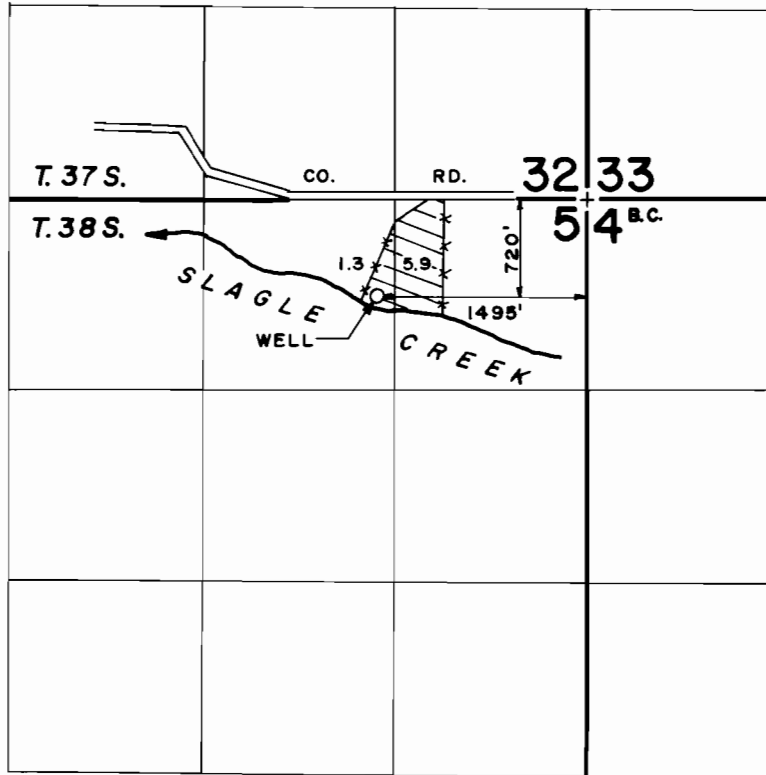

**FINAL PROOF SURVEY**  
UNDER

Application No. ~~G-6353~~ Permit No. ~~G-5235~~  
IN NAME OF

**WILLIAM STRECKER**

Surveyed ~~JULY 27~~ 19~~83~~, by ~~B. JAMES~~