


T. 2S., R. 2W., W.M.

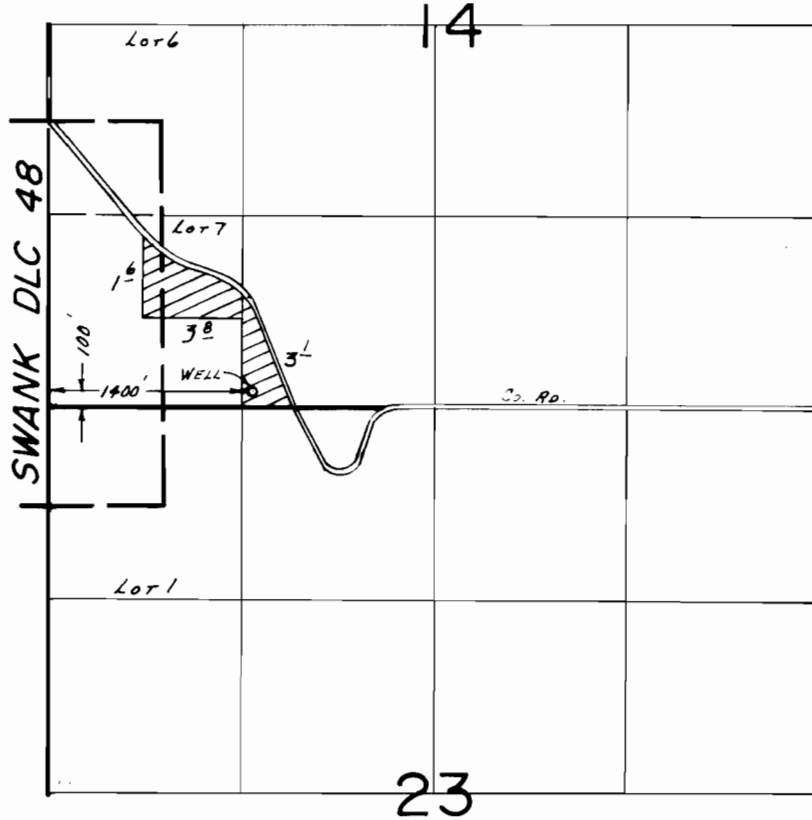

SCALE: 1"=1320'

FINAL PROOF SURVEY
UNDER

Application No. G-5813. Permit No. G-5243.....
IN NAME OF

.....ROGER DEAN BERRYHILL.....

Surveyed July 17.... 1984, by B.W. BISHOP.....