



T. 5N. R. 32E. W.M.

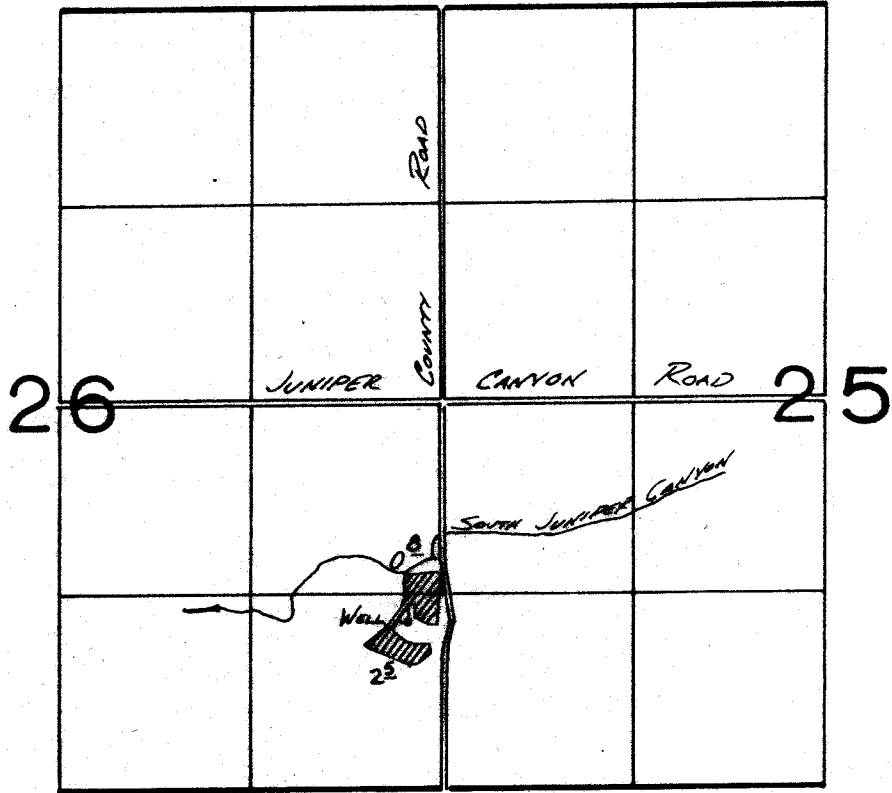

WELL LOCATION 1120' N. ; 230' W. FROM SE COR. SEC. 26

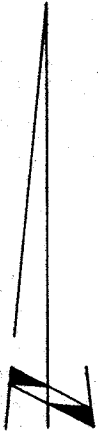

Scale 1" = 1320'

FINAL PROOF SURVEY
UNDER

Application No. G-6374 Permit No. G-5252
IN NAME OF

HILL RANCHES, INC.

Surveyed JULY 29 1982, by V. CHURCH
3-27 87

