


# T.13S.,R.3W.,W.M.

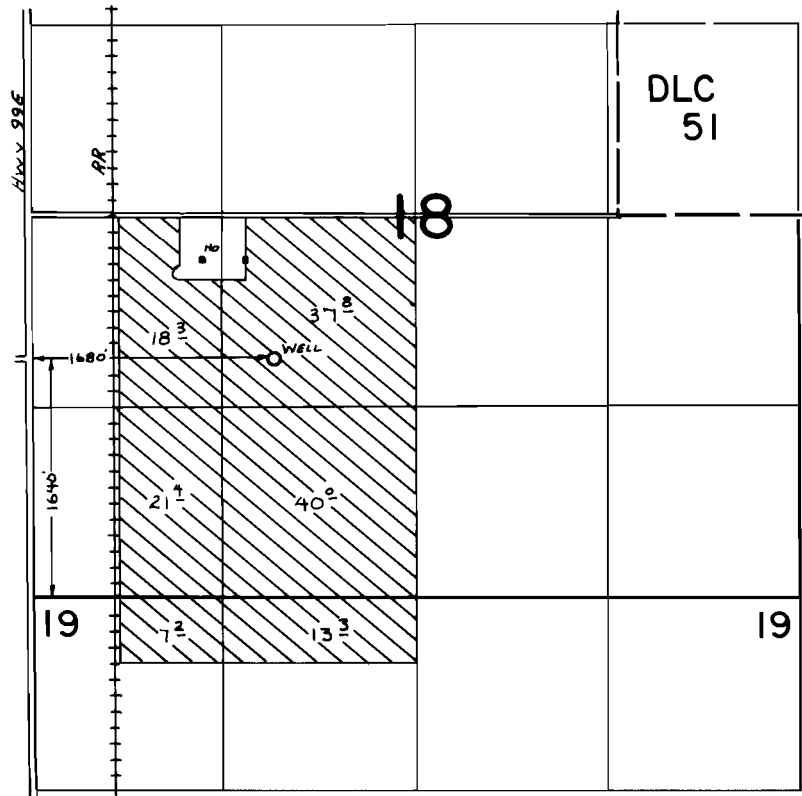

## FINAL PROOF SURVEY UNDER

Application No. ..G-5588 Permit No. ...G-5445...  
IN NAME OF

..HUGH S. & NADYNE DICKSON.....

Surveyed April 23, 1982., by J.L.M. TOLL.....