


T.12S.R.2W.W.M.

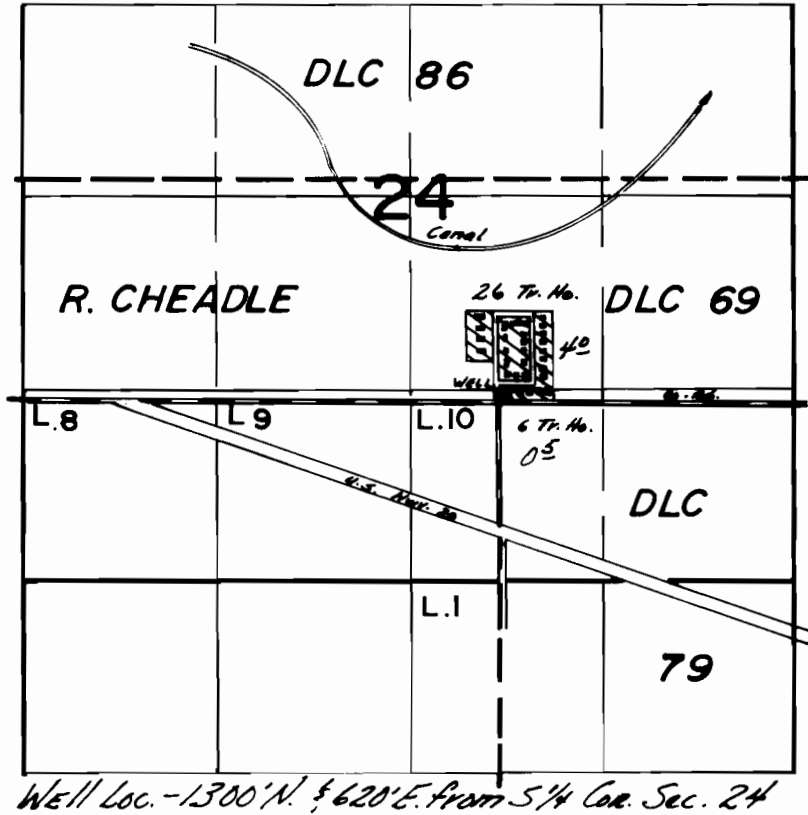

FINAL PROOF SURVEY
UNDER

Application No. G.-5739 Permit No. G.-5534...
IN NAME OF

HAROLD W. & DONA L. BATES.....

Surveyed **May 3**... 1979., by **S.C. BROWN**.....