


T.10S. R.1W. W.M.

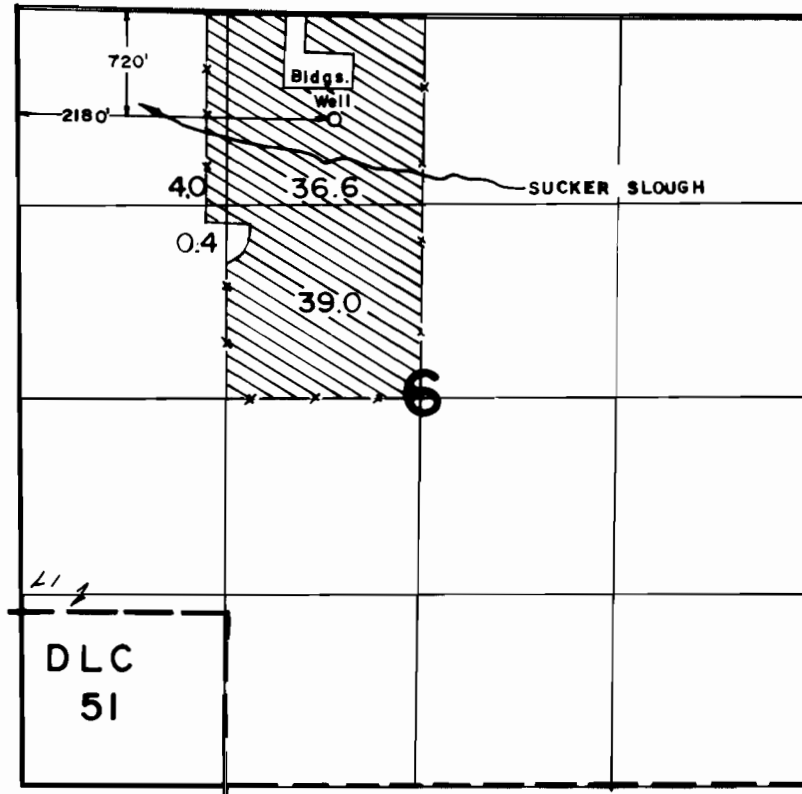

FINAL PROOF SURVEY UNDER

Application No. **G-57.73** Permit No. **G-555.1**.....
IN NAME OF

BENJAMIN & JANELLE L. UNRUH

Surveyed **MAY....1.... 1979.**, by **S.C. BROWN**.....