


T. 4 N. R. 25 E. W.M.

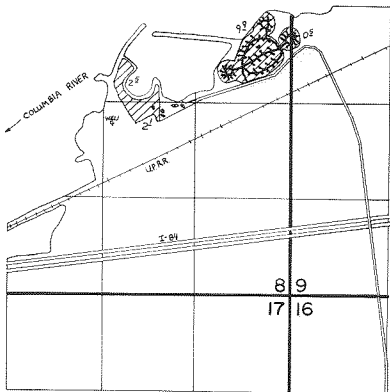

WELL LOC. 280' S. 1/4 2490' W. FROM E. 1/4 COR. SEC. 8

**FINAL PROOF SURVEY**  
UNDER

Application No. G.5870. Permit No. G.5602.....  
IN NAME OF

.....CORPS OF ENGINEERS.....

Surveyed Jan. 30, 1987, by V. Church.....

RECEIVED  
FEB 0 1987