


T.19 & 20S. R.1E. W.M.

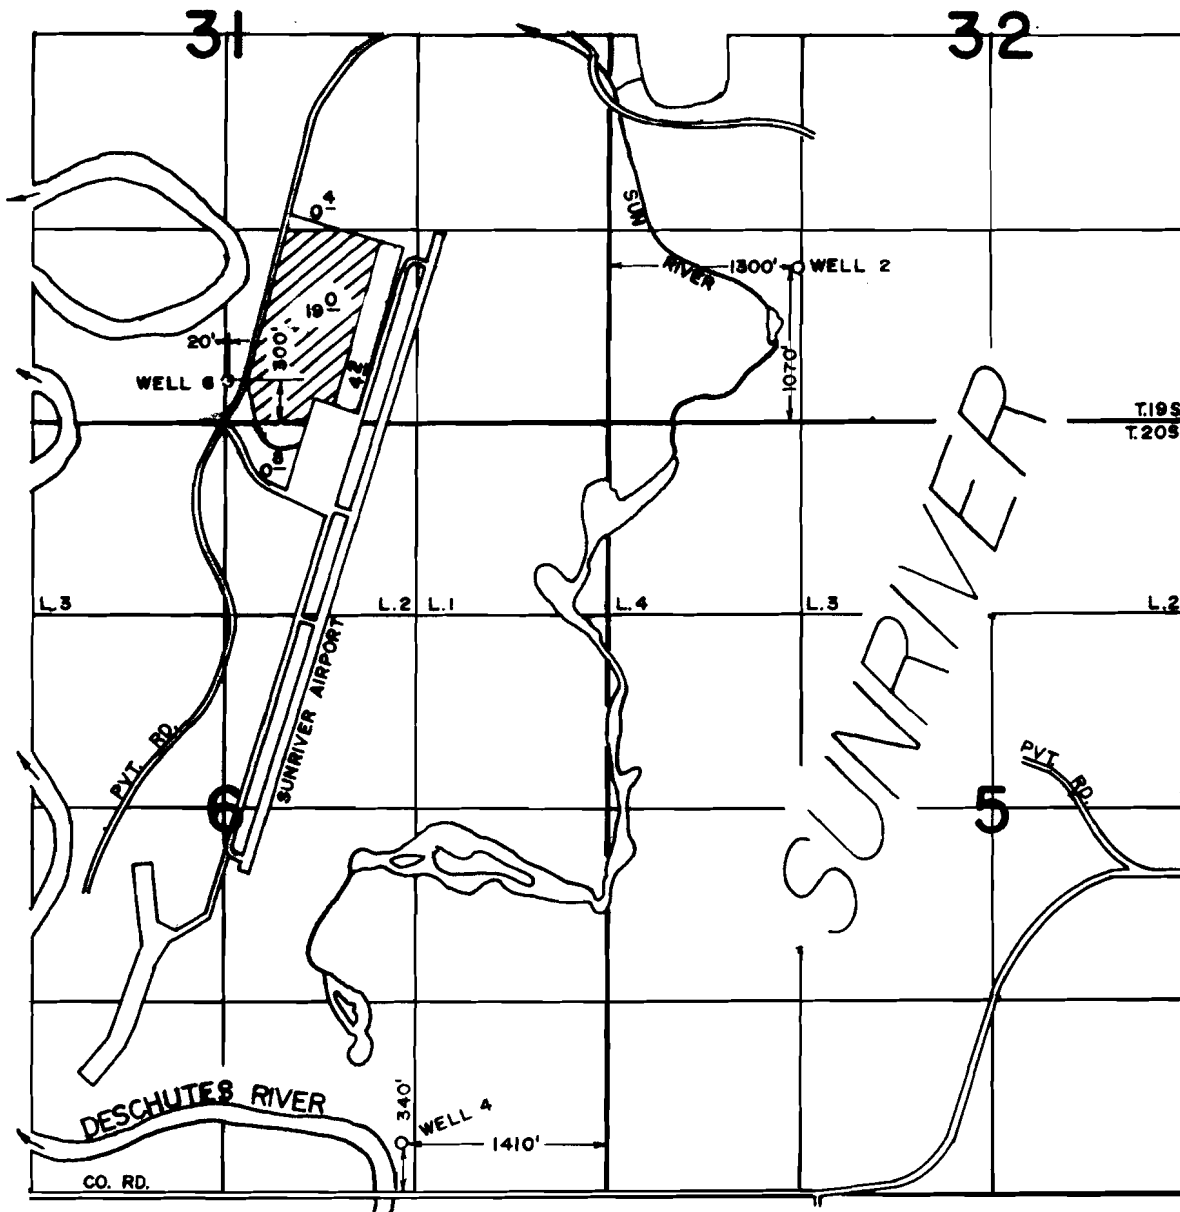

FINAL PROOF SURVEY UNDER

G-4064 G-3810

G-5883 G-5609

Application No. G-5884... Permit No. G-5610.....

IN NAME OF

SUNRIVER PROPERTIES, INC.....

Surveyed JUL... 23... 1980., by L.H. NUNN.....

RECEIVED

DATE 6-30-88

WATER MASTER DISTRICT #11

BY *SM*

Cent. 57066