


T.5S., R.1W., W.M.

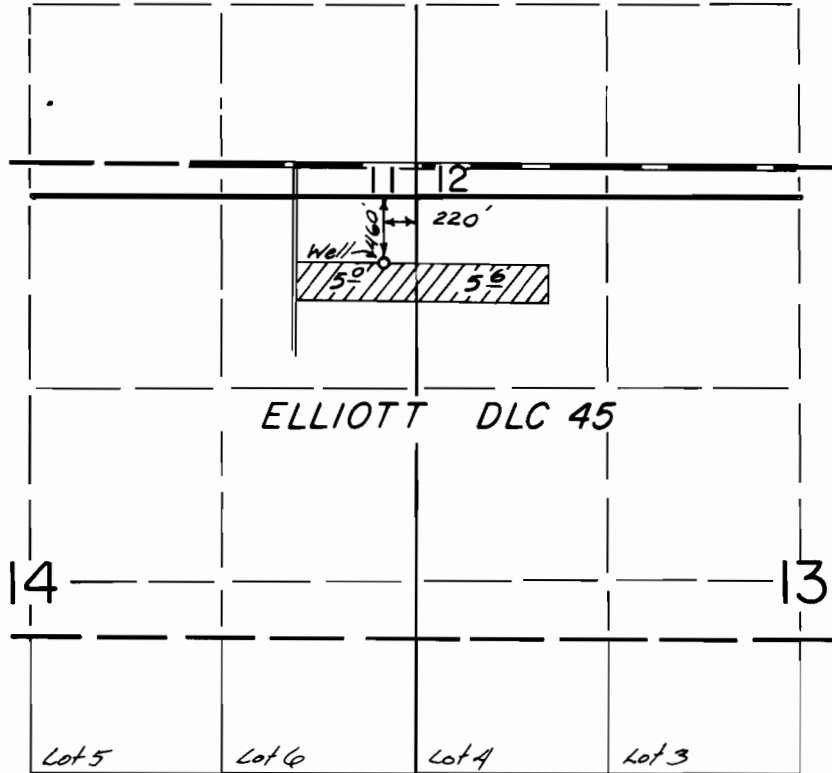

FINAL PROOF SURVEY UNDER

Application No. G-7083 Permit No. G-5827..

IN NAME OF

DIMITRY CHASCHIN

Surveyed MAY 19, 1980, by *John Brown*