

12.6-1945 ✓  
12.6-S-W-1955 ✓

211.2 Ac. - W A  
1945

-1945 ✓  
S-W-1955 ✓

33.6-1945 ✓  
33.6-S-W-1953 ✓  
3.6-1946 ✓

7.6-1946 ✓

0.3-1859 ✓

5.8  
4.7-1  
Dom-1

-1945 ✓  
S-W-55 ✓

30-1945 ✓  
30-S-W-55 ✓  
11.4-1946 ✓

29.1-1946 ✓  
0.3-W-1945 X

15.8-1859  
2.8-1859  
0.8-W-1945 X

1945 ✓  
S-W-55 ✓

29.4-1945 ✓  
29.4-S-W-55 ✓  
10.6-1946 ✓



7-1859 ✓  
8.6-1944 ✓  
11.2-W-1945 ✓  
5-S-1960 ✓

11-1859  
0.1-1946 ✓  
2.2-W-1945 ✓  
0.8-1960  
2.2-S-1960

5 ✓  
-55 ✓

8-1905 ✓  
Dom-1854  
1.5-1874 ✓  
21-1945 ✓  
21-S-W-55 ✓  
10.8-W-1948 ✓  
1.5-S-1960 ✓

10.7-W-1945 ✓

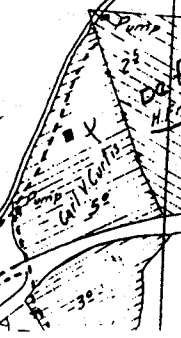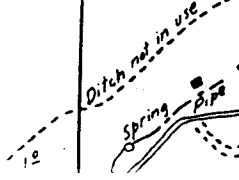

Becker Default  
Default

Spring 10.7-S-1960

Denton

Jacobson Ditch

Ditch

Jacobson's Ditch

Goody Road

Barbara A. Guy - Def Fa. H

Spicferman Default

6.4-18