


T.10S.,R.2W.,W.M.

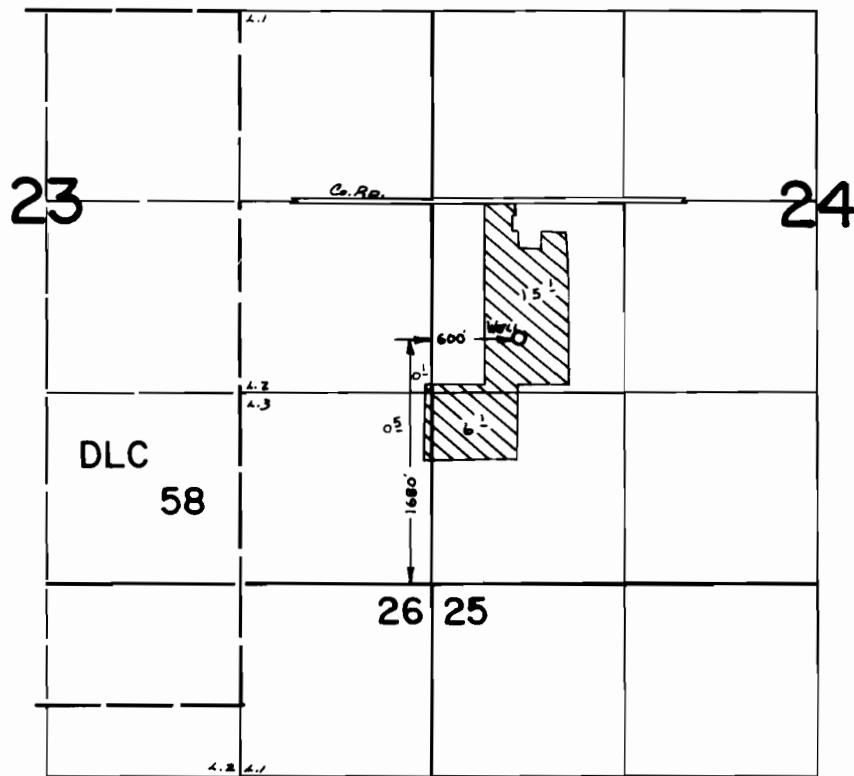

FINAL PROOF SURVEY UNDER

Application No. .G-6149. Permit No. .G-5838....

IN NAME OF

L. P. APPLEBY &
..... THOMAS D. TRISSEL.....

Surveyed June 30, 1982, by L.M.TOLL.....