


T. 1N., R. 39E., W.M.

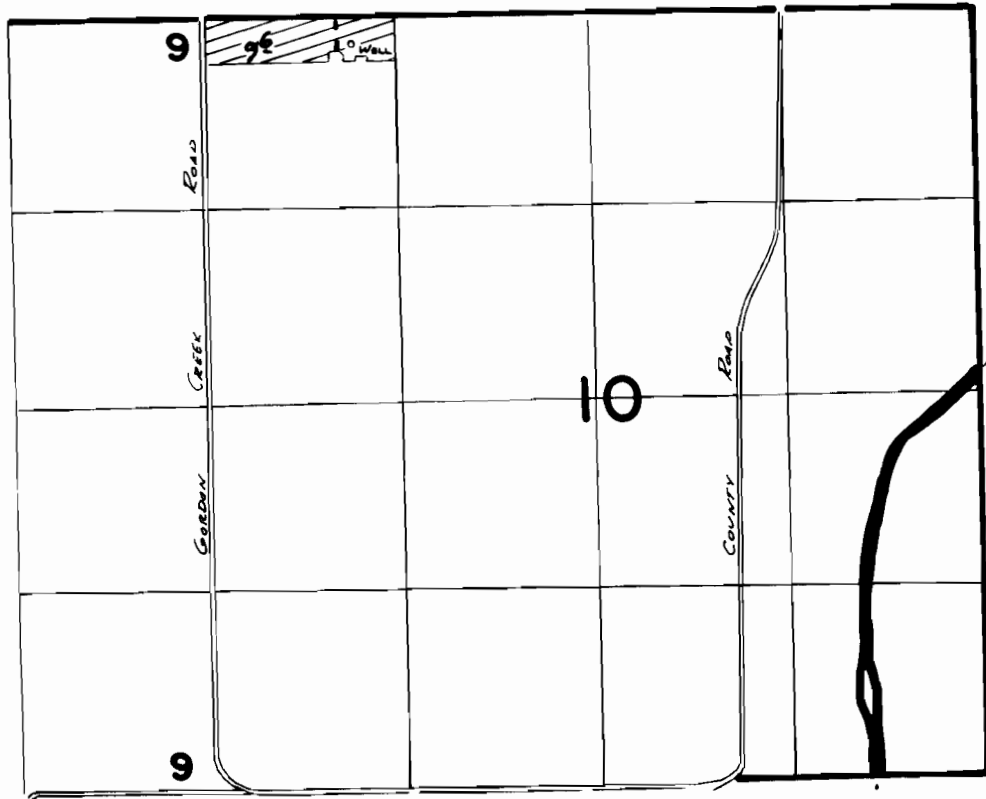

WELL Loc: 190'S & 1000'E FROM NW COR. SEC 10

FINAL PROOF SURVEY
UNDER

Application No. **G-6204** Permit No. **G-5867**
IN NAME OF

GERALD DOUD

Surveyed Aug. 23, 1983, by **V.L. Church**