


T.14S.,R.2W.,W.M.

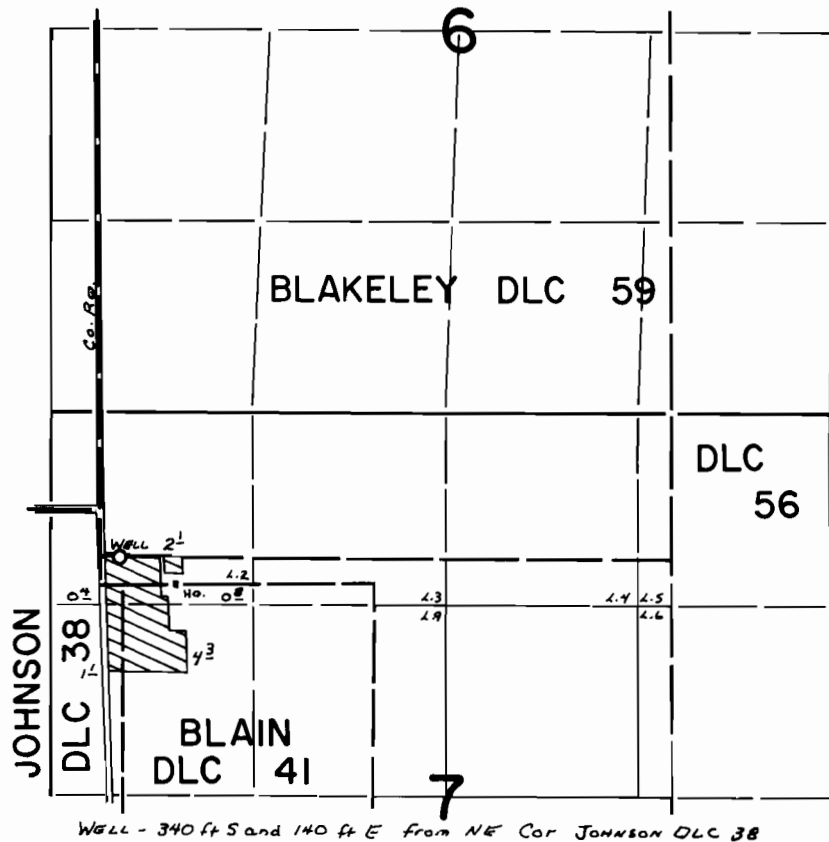

WELL - 340 ft S and 140 ft E from NE Cor JOHNSON DLC 38

**FINAL PROOF SURVEY**  
UNDER

Application No. ..G:6346 Permit No. ...G:5249...  
IN NAME OF

...GAROLD & BLANCHE FISCUS...

Surveyed April 27, 1982, by ..L.M.TOLL.....