


T. 3S., R. 2W., W.M.

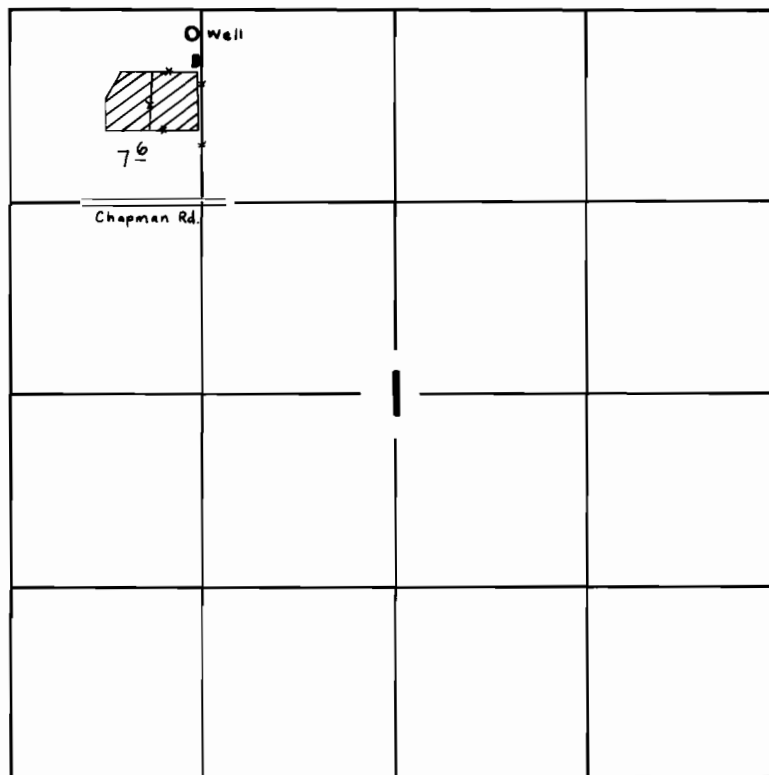

Well Loc: 150' S. & 1250' E. fr. N.W. cor. sec. 1

SCALE: 1" = 1320'

FINAL PROOF SURVEY
UNDER

Application No. G-6412 Permit No. G-5993
IN NAME OF

ROBERT G. MURDOCK

Surveyed NOV 8 1983, by L. TOLL