


G-6123
57079

T. 41S. R. 10E. W. M.

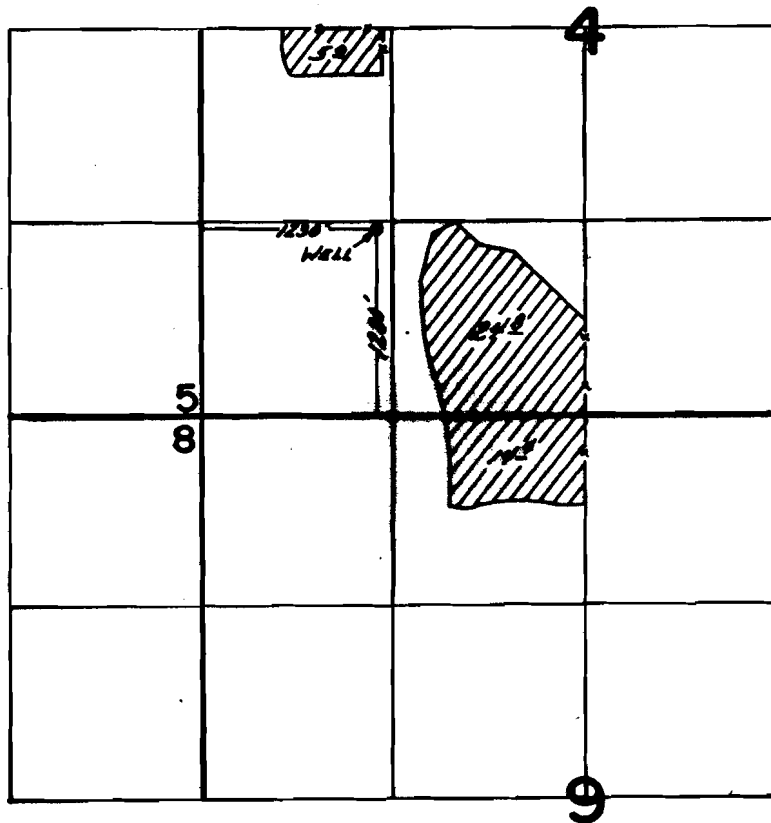

FINAL PROOF SURVEY UNDER

Application No. G-6511... Permit No. G-6123...
IN NAME OF

Joseph C. & Walter W. Fotheringham

Surveyed Sept. 19. 1979, by C. RODRIGUEZ.