


T. 7 S., R. 2 W., W.M.

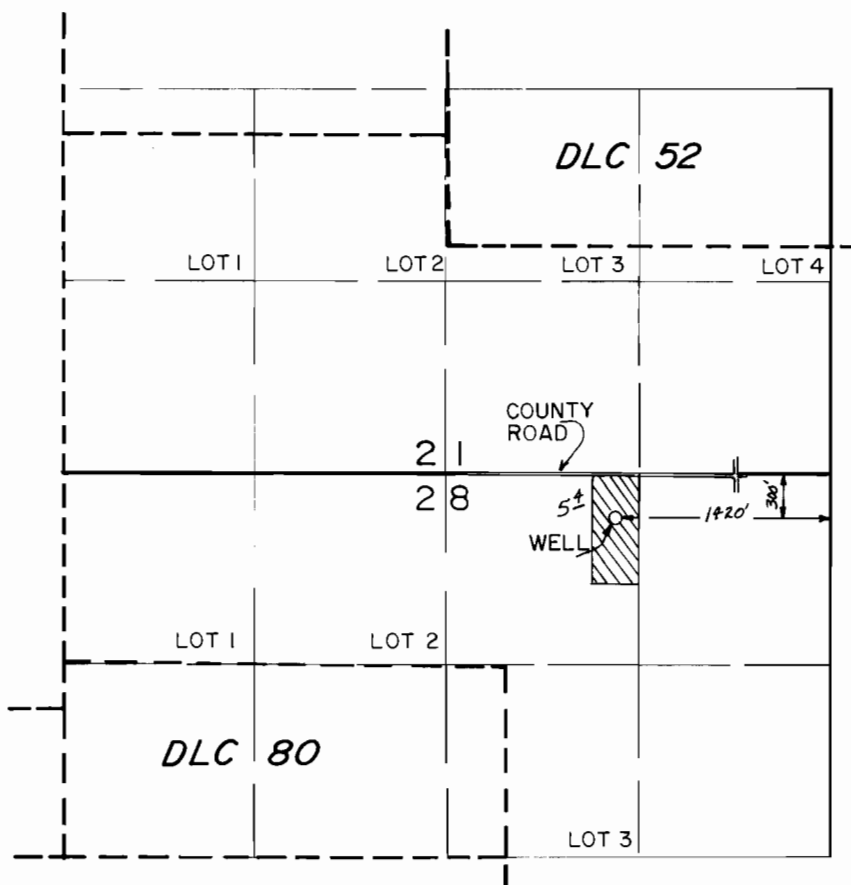

SCALE: 1" = 1320'

FINAL PROOF SURVEY UNDER

Application No. G-6650 Permit No. G-6211
IN NAME OF

PHYLLIS JUNE BOATWRIGHT

Surveyed AUG. 22 1985, by B. W. BISHOP