


6-6286  
57083

# T.39S.R.8 & 9 E.W.M.

U. River Wells

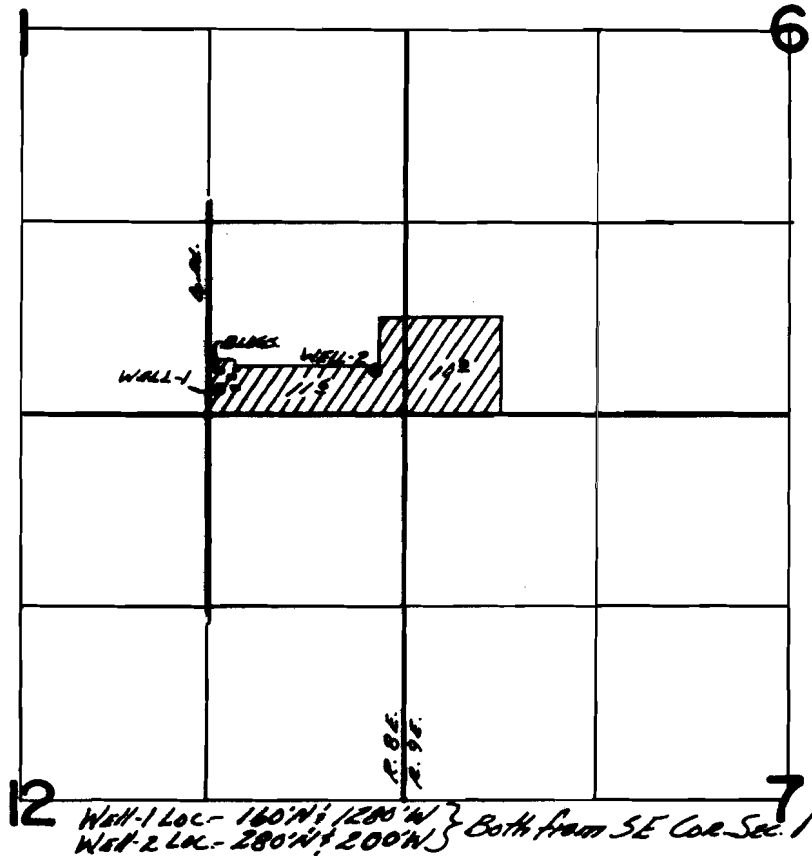

## FINAL PROOF SURVEY UNDER

Application No. G-6766 Permit No. G-6286  
IN NAME OF

DELBERT RAY BROYLES

Surveyed Sept. 22, 1979., by C.R. RODRIGUEZ.