


T.5S. R.2W. W.M.

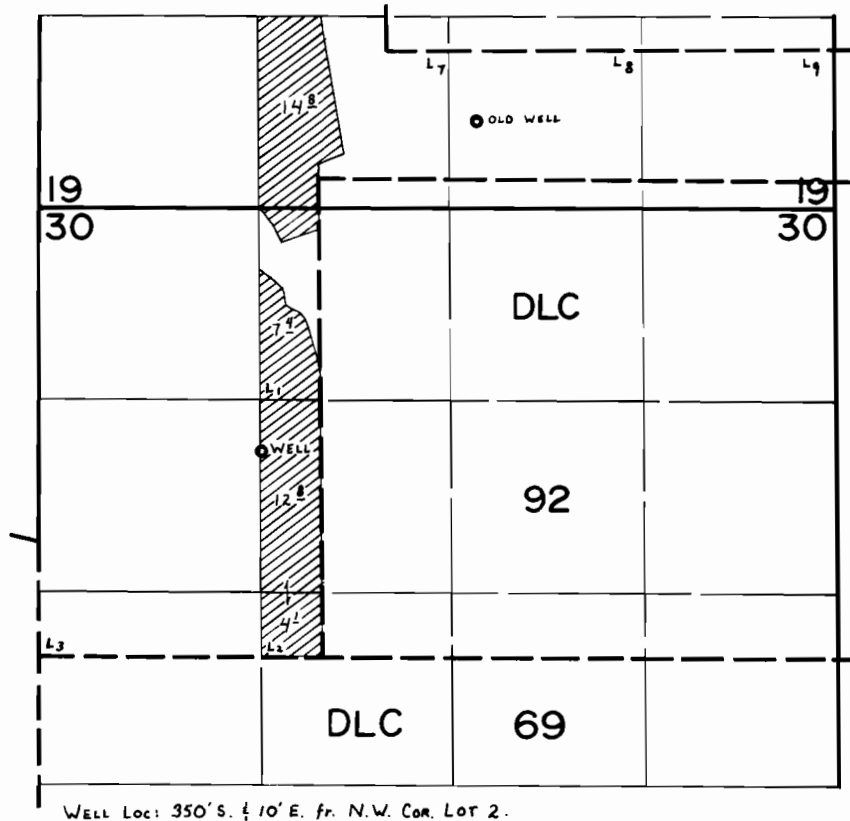

FINAL PROOF SURVEY UNDER

Application No. G-6781.. Permit No. G-6294.....
IN NAME OF

JESS W. & FLORENCE N. LUCAS

Surveyed July...8... 19.80, by ...C.L...Hughes.....