


T.6S.,R.IW.,W.M.

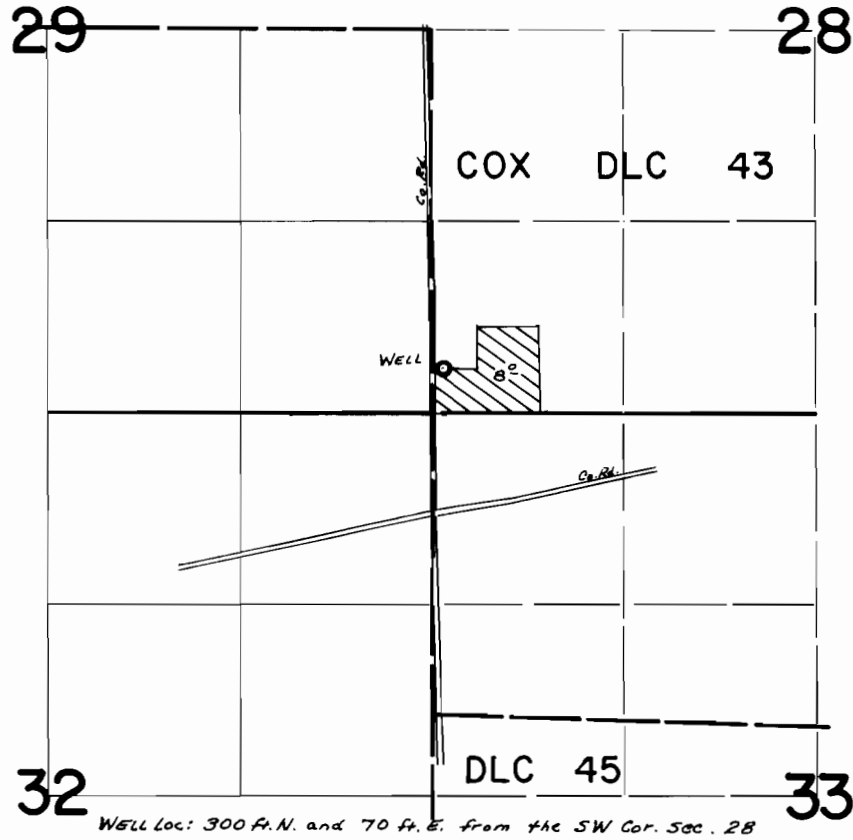

FINAL PROOF SURVEY UNDER

Application No. G-6810 Permit No. G-6314
IN NAME OF

LARRY MATHEWS

Surveyed Oct. 14 1981, by S. C. BROWN