


T. 11S., R. 3W., W.M.

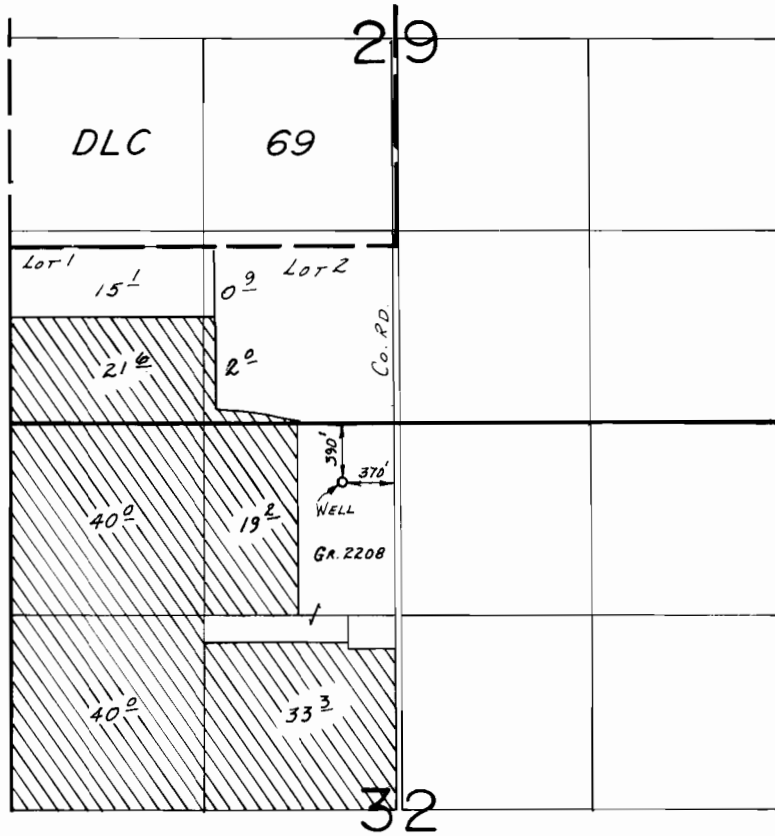

SCALE: 1" = 1320'

FINAL PROOF SURVEY UNDER

Application No. G-7832 Permit No. G-7218.....
IN NAME OF

.....HUGO EHRLICH, Jr.

Surveyed May 4..... 19.84, by L.M. TOLL.....