


T.1S.,R.2W.,W.M.

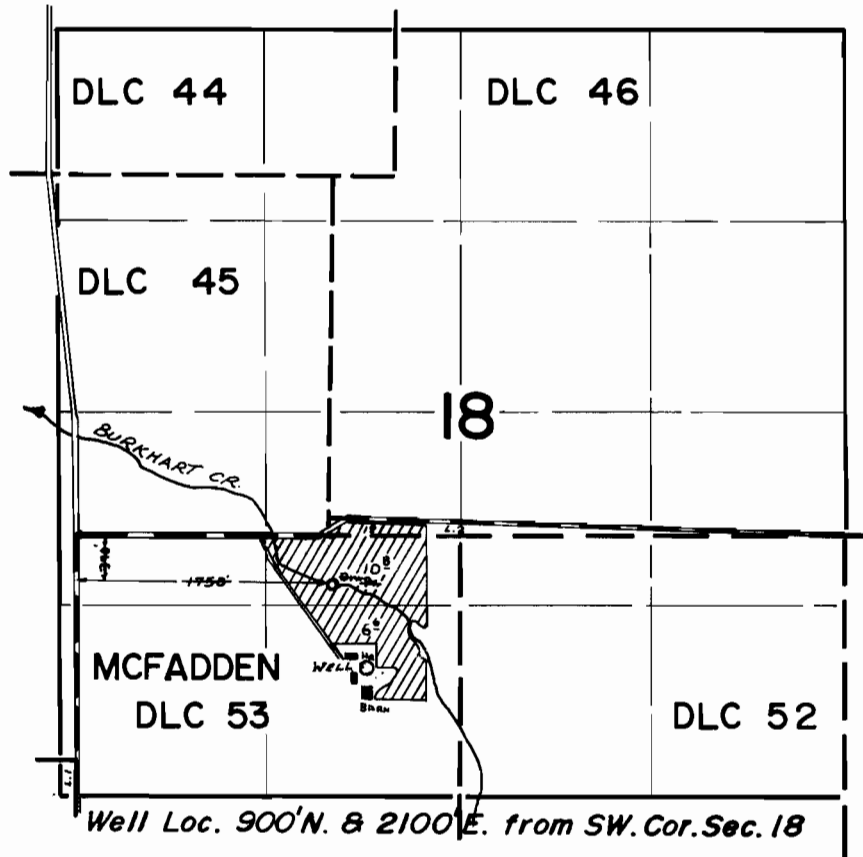

**FINAL PROOF SURVEY**  
UNDER

Application No. ~~47088~~ <sup>G-7015</sup> Permit No. ~~35233~~ <sup>G-6369</sup>  
IN NAME OF

EARL W. STUTZMAN

Surveyed ~~Oct. 15, 1974~~ by ~~L. Tett~~  
" April 25 1979, by S.C. BROWN