


T. 2S., R. 4 & 5E., W.M.

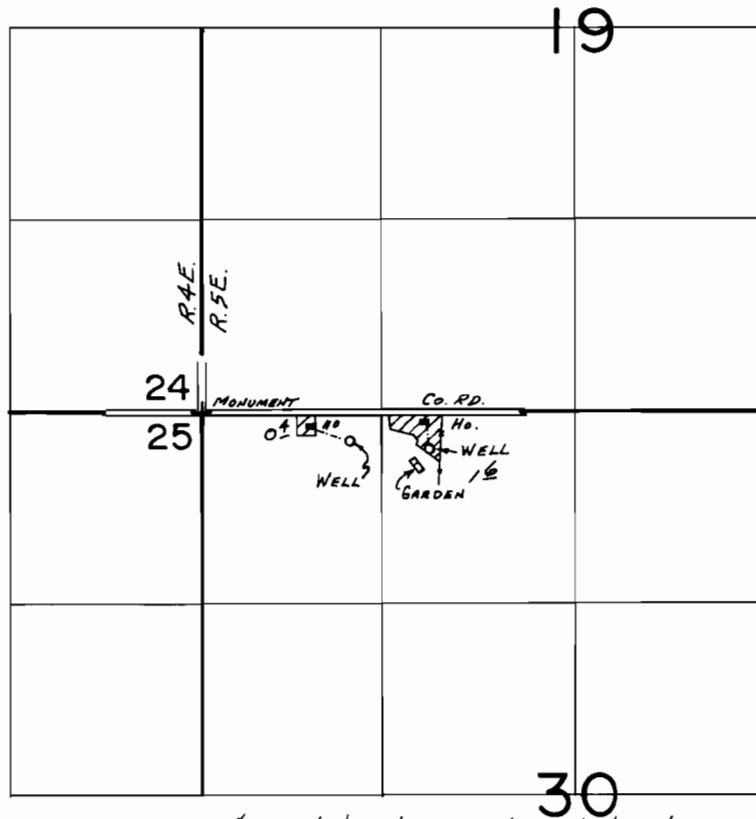

WELLS LOC: WELL #1 - 190'S. & 1020'E, WELL #2 - 250'S. & 1550'E, BOTH FROM NW COR. SEC. 30.

# FINAL PROOF SURVEY

## UNDER

Application No. G-7283 Permit No. G-6387  
IN NAME OF

FRED E. WICKERSHAM

Surveyed MAY 10... 1979, by R.G. MUCKEN.....