


T. 40 S., R. 8 W., W. M.

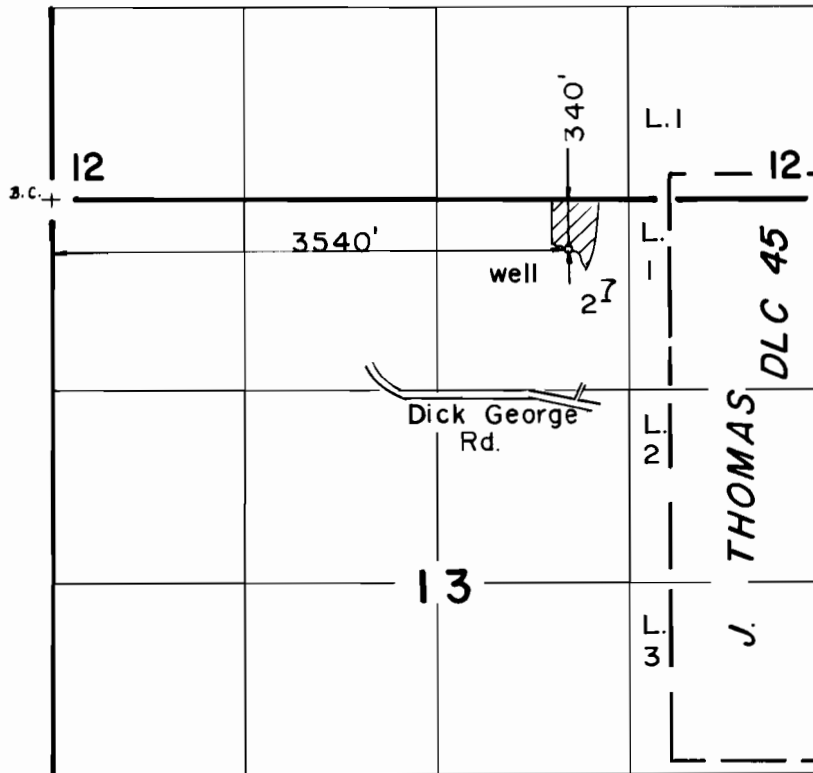

Scale: 1" = 1320'

FINAL PROOF SURVEY
UNDER

Application No. **G-6854** Permit No. **G-6393**
IN NAME OF

JAMES R. FRANKS

Surveyed **APR. 2, 1986**, by **B. S. JAMES**