


T.7S. R.2W., W.M.

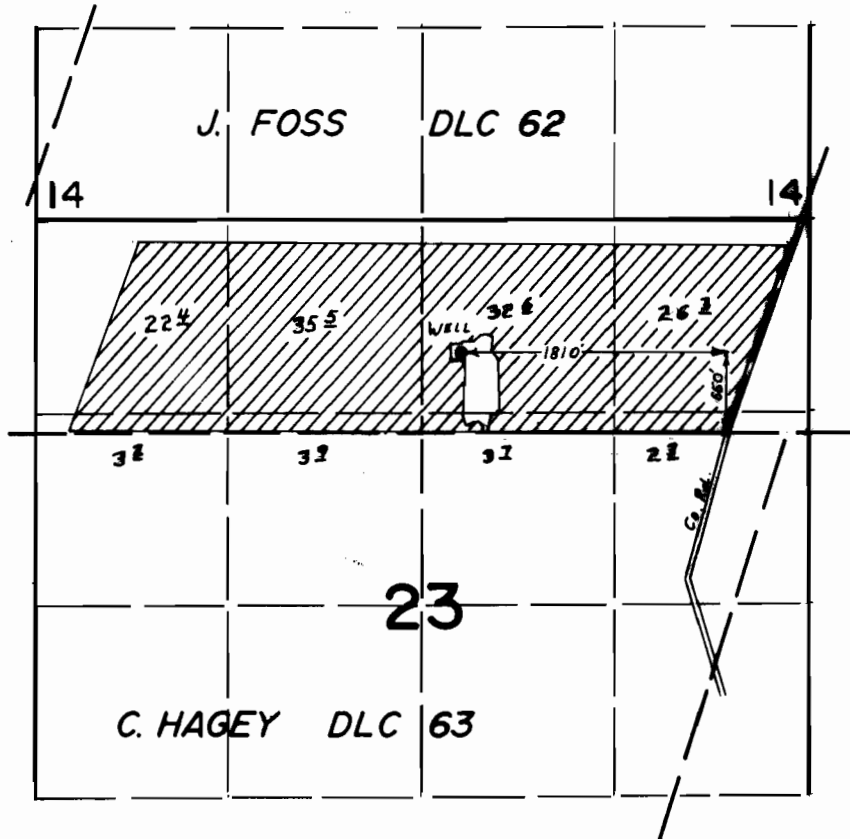

FINAL PROOF SURVEY UNDER

Application No. G-6884. Permit No. G-6415.....
IN NAME OF

JAMES E. & ANNA G. FRAZIER.

Surveyed MAY. 16... 1979., by L.H. NUNN.....