


G-8739
57092

T.26&27S.,R.17E.,W.M.

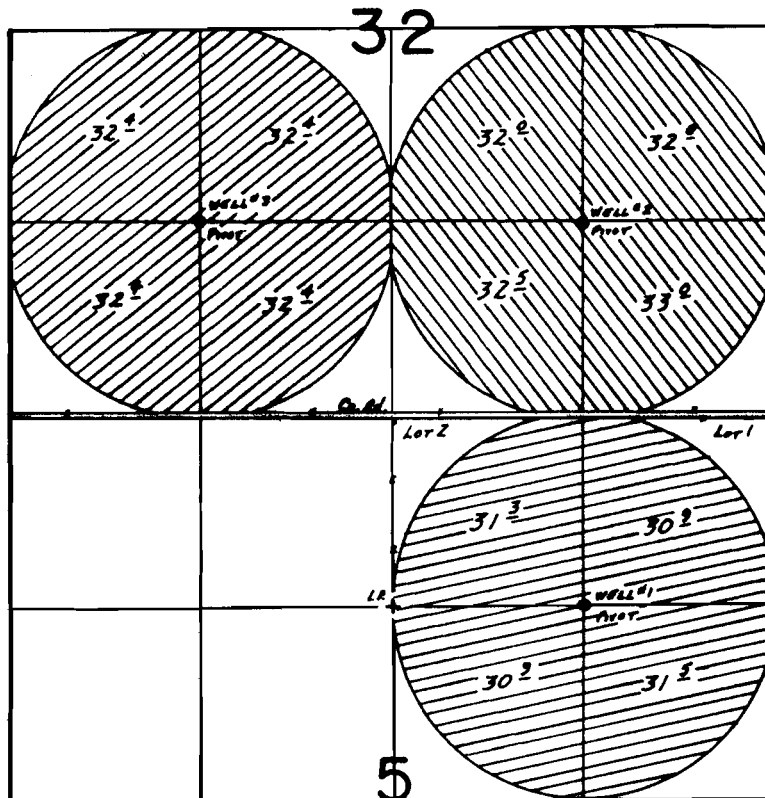

WELLS LOC: #1- 1300'S. & 3960'E, #2- 1300'N. & 3960'E, #3- 1320'N. & 1320'E, ALL FROM SW COR. SEC. 32.

-  Well No. 1
-  Well No. 2
-  Well No. 3

Scale: 1"=1320'

FINAL PROOF SURVEY UNDER

Application No. G-9380 Permit No. G-8739.....
IN NAME OF

.....MELVIN D. & RAMONA HALL

Surveyed OCT. 16... 1984, by B.W. BISHOP.....