


P-28266
57093

T.17S., R.27E., W.M.

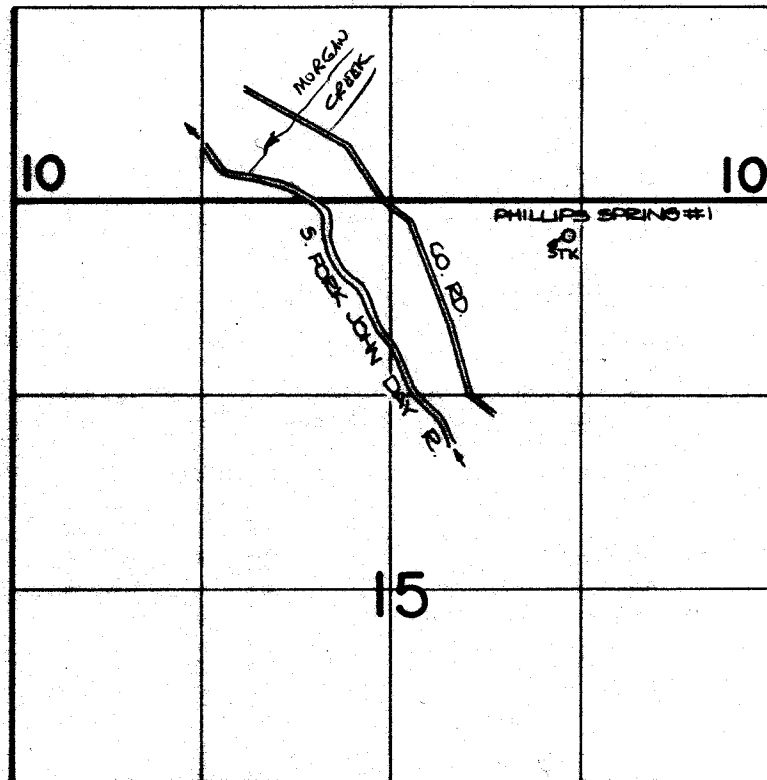

THE SPRING IS LOCATED 250 FT. S. AND 1240 FT. E.
FROM THE N. 1/4 CORNER OF SECTION 15.

FINAL PROOF SURVEY
UNDER

SCALE: 4"=1 MILE

Application No. 35398.. Permit No. 28266.....
IN NAME OF

BUREAU OF LAND MANAGEMENT

Surveyed AUG. 11, 1984, by P. Fagan