
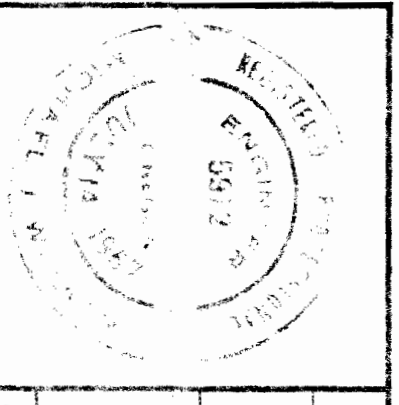


DIVERSION POINT IS SOUTH 2020 FEET
 & 1980 FEET WEST OF THE N.E. COR
 OF SECTION 28, T.3N., R.5W., W.M
 WASHINGTON COUNTY, ORE.

Application No. 48910
 Permit No. 35817

REVISED 12/24/71, ADDED DISTRICT BOUNDARY.

RECEIVED
 DEC 29 1971
 STATE ENGINEER
 SALEM, OREGON

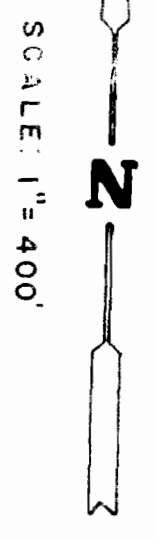

TIMBER WATER ASSOCIATION	
PROPOSED DEVELOPMENT	
CLARK & GROFF ENGINEERS INC.	
ENGINEERING ARTS BUILDING	
2376 Commercial, S. E.	
SALEM, OREGON	
DRWG. R. E.	CHKD.
DATE	OCTOBER 1971
SHEET	1A
NO.	7192