
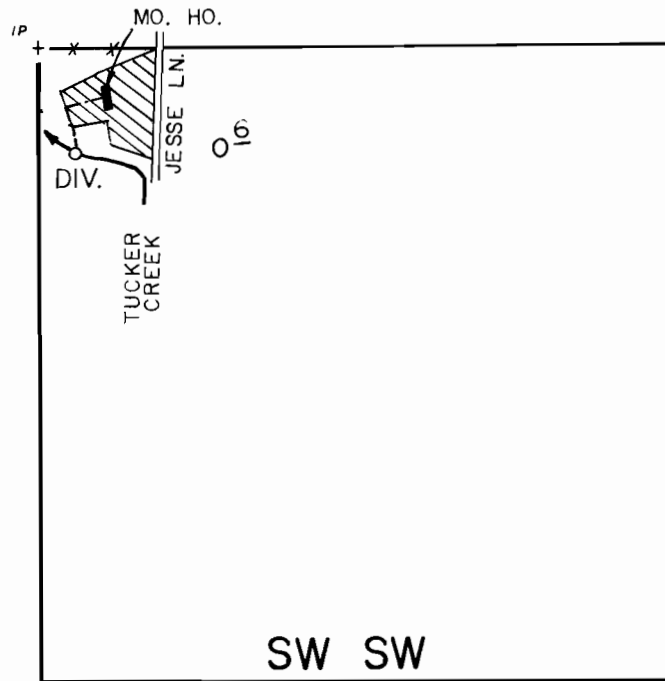


T.28S., R.5W., W.M.

SEC 12

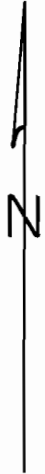

DIV. LOC.: 220' S. & 80' E. FROM S. 1/16
BETWEEN SEC. 11 & 12.

SCALE: 1" = 400'

FINAL PROOF SURVEY
UNDER

Application No. 49276 Permit No. 36930.....
IN NAME OF

.....**LENORA HELIAS**.....

Surveyed JULY 9, 1984, by *J.E. Carlson*.....