


T. 38 S., R. 7 W., W.M.

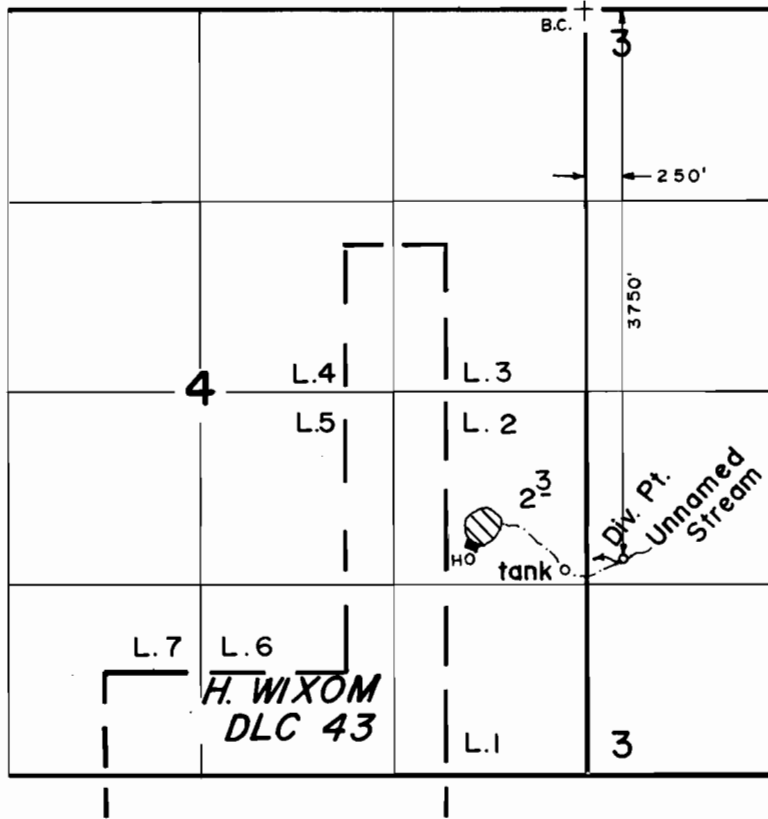

SCALE: 1" = 1320'

FINAL PROOF SURVEY
UNDER

Application No. 49292 Permit No. 36965...
IN NAME OF

.....JERRY.....R.....BUCKHAULTS.....

Surveyed JUN. 19... 1986, by B. S. JAMES.