


T.34 S., R.1 W., W.M.
SEC. 21

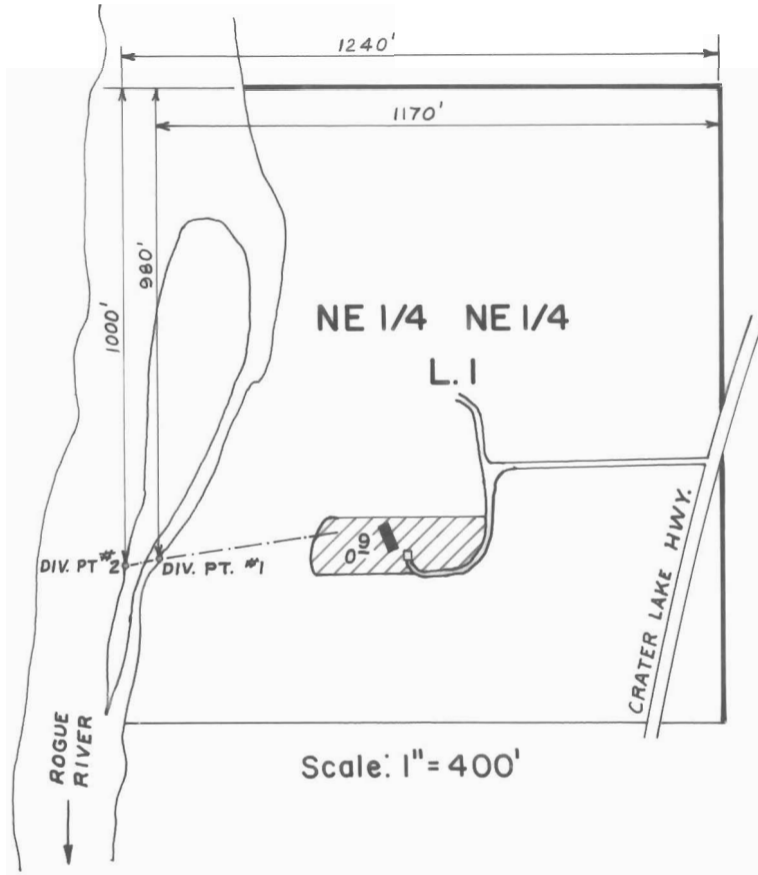

FINAL PROOF SURVEY
UNDER

Application No. **49469** Permit No. **37056**...
IN NAME OF

JAMES K. & PEGGIE WOODWORTH

Surveyed **JUNE 24 1983**, by **B. S. JAMES**...