


T.38S. R.4W. W.M.

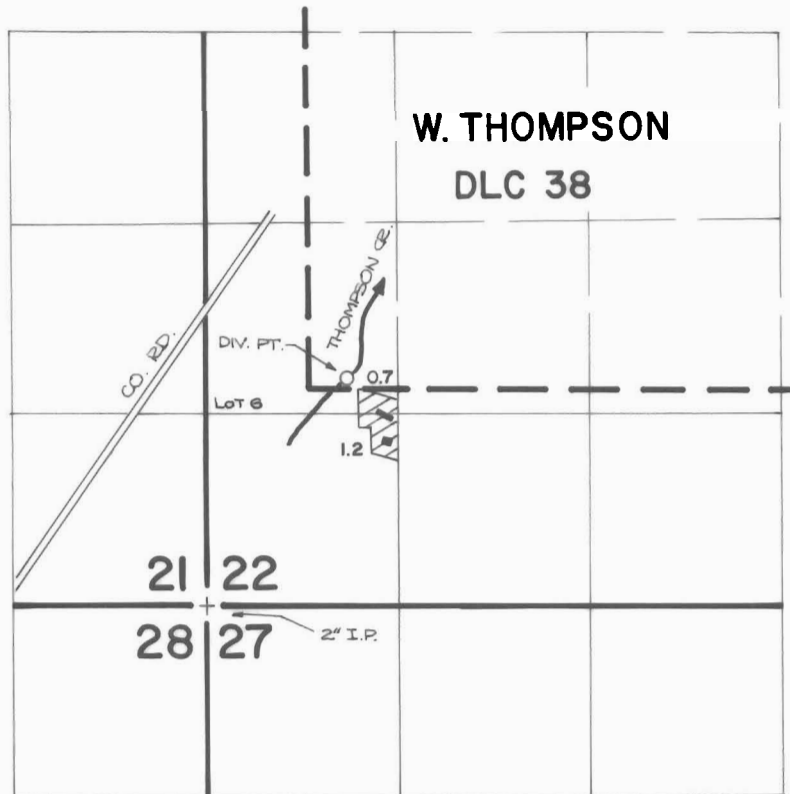

DIV. PT. 80' N & 280' E FROM SW COR DLC 38

FINAL PROOF SURVEY
UNDER

Application No. **49571** Permit No. **37099**
IN NAME OF

RANDOLPH MARTIN

Surveyed **JULY..27. 19.83.**, by **..B..JAMES.....**