
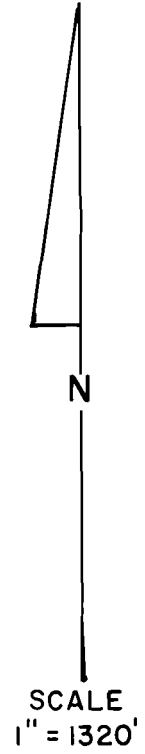


# T. 1 S., R. 7 W., W.M.

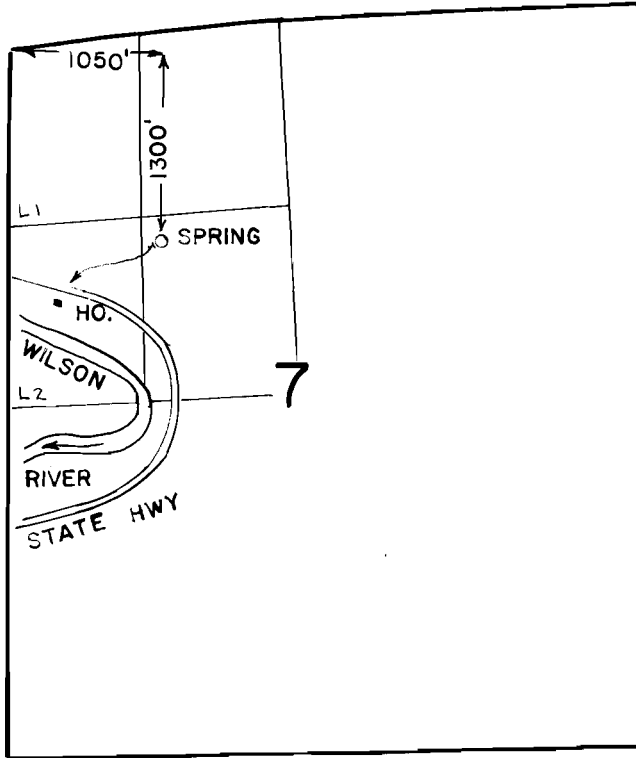

## FINAL PROOF SURVEY UNDER

Application No. 50356... Permit No. 37157.....  
IN NAME OF

MELVIN B. WELLS.....

Surveyed APR 6 1978, by S. DONALDSON