


T. 10 S., R. 1 W., W.M.

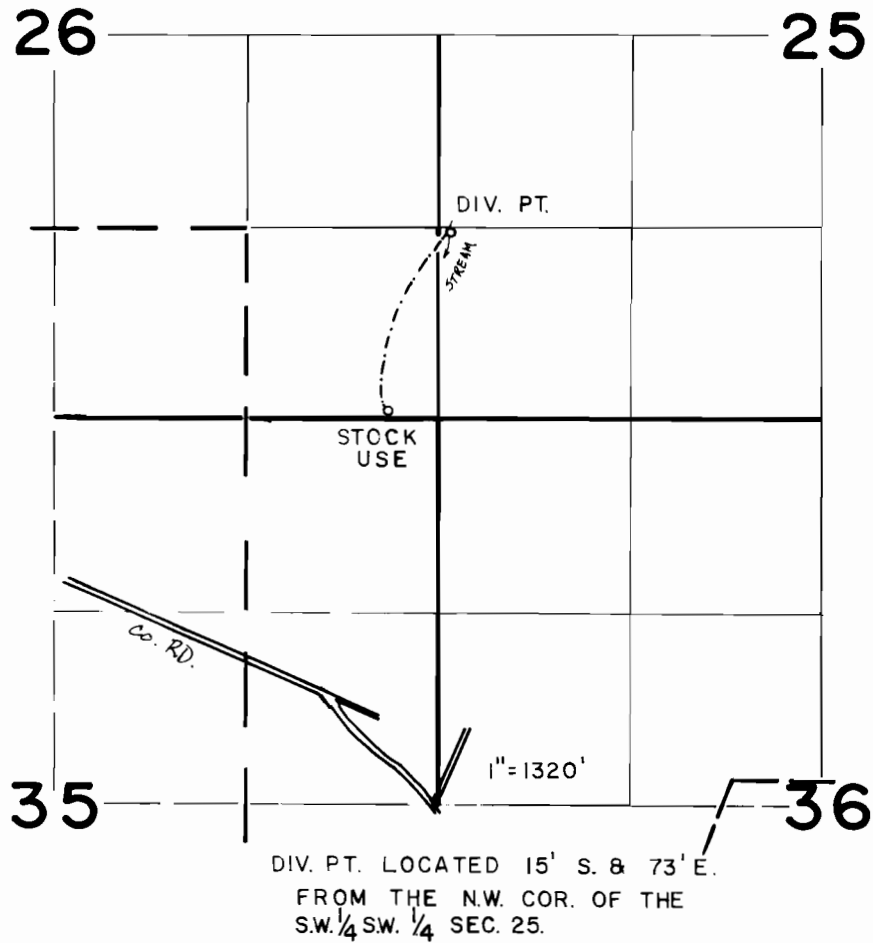

FINAL PROOF SURVEY
UNDER

Application No. 49733 Permit No. 37244
IN NAME OF

CHRISTIAN J. REBMANN

Surveyed OCT. 12, 1983, by M. CAHILL