


T. 3S., R. 38E., W.M.

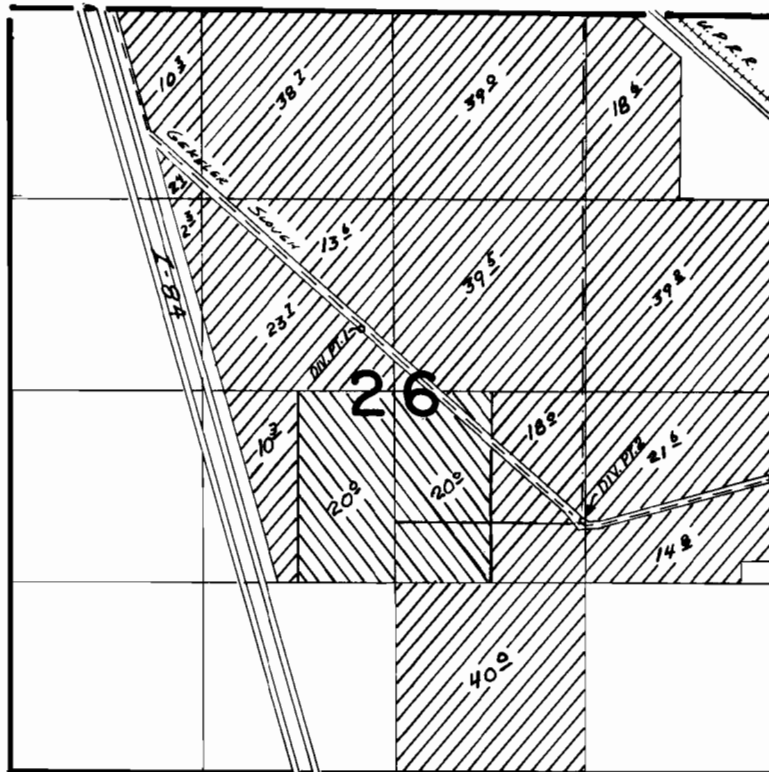

DIV. PT. 1 LOC. 2170' S. AND 2410' E. FROM N.W. COR. SEC. 26
DIV. PT. 2 LOC. 3480' S. AND 3940' E. FROM N.W. COR. SEC. 26



PRIMARY



SUPPLEMENTAL

FINAL PROOF SURVEY UNDER

Application No. **50231** Permit No. **37417**
IN NAME OF

JOE & WILMA RINKE

Surveyed **AUGUST 26, 1993**, by **V.H. SHARSH**