


T.5S.R.10W.W.M.

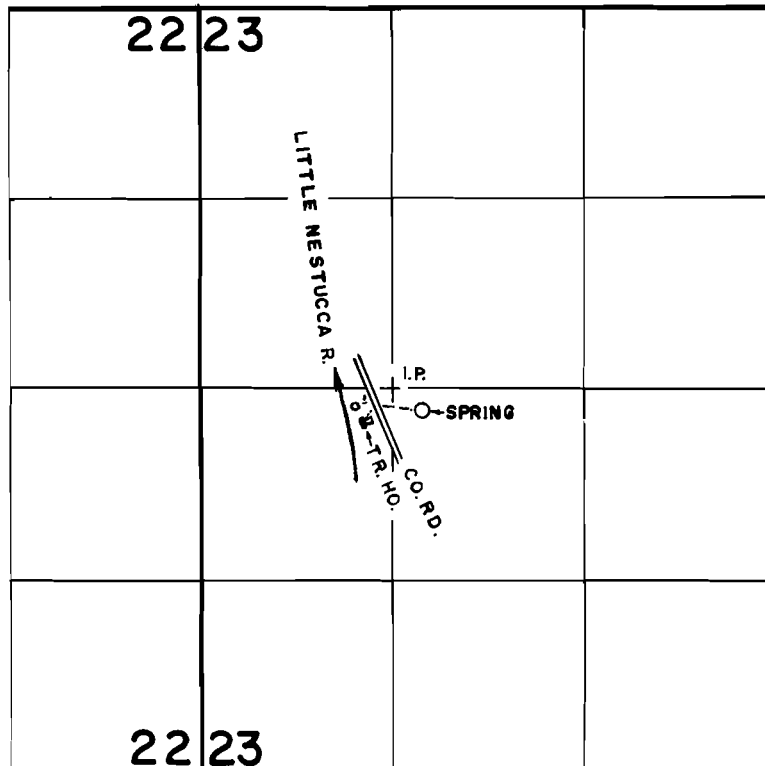

DIV. PT. LOC. 150'S. & 200'E. FROM N.E.COR. NW. 1/4 SW. 1/4 SEC. 23

FINAL PROOF SURVEY
UNDER

Application No. 50244. Permit No. 37958.....
IN NAME OF

.....FRANK N. and DORIS R. WARD.....

Surveyed JAN. 22. 1980, by R.G. MUCKEN.....