


T. 5S., R. 6W., W.M.

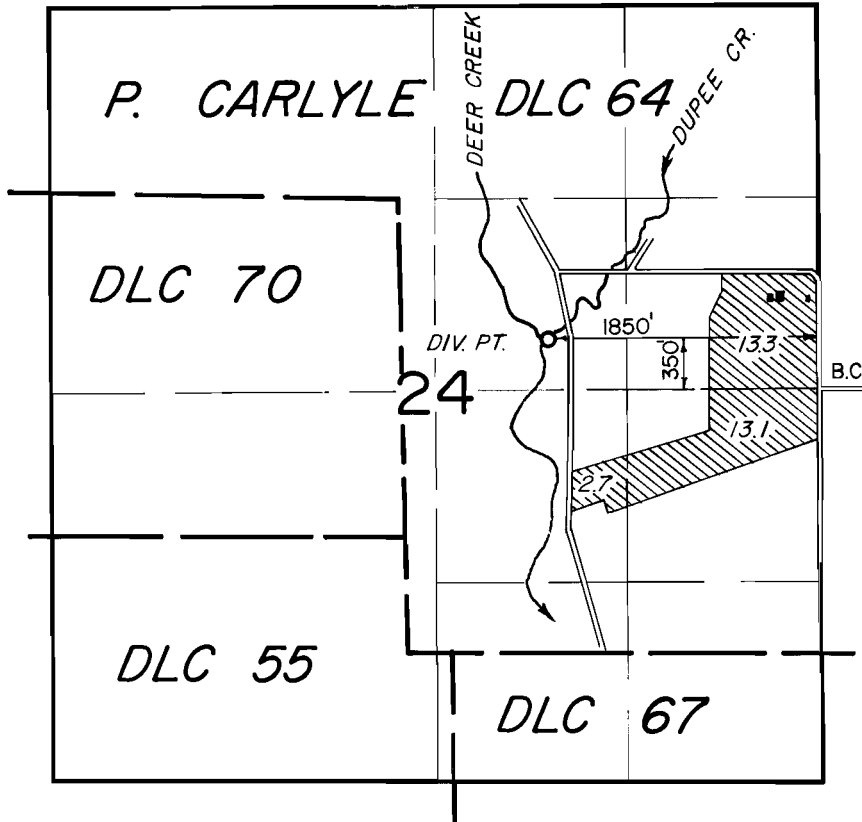

FINAL PROOF SURVEY UNDER

Application No. 50286.. Permit No. 37968
IN NAME OF

Eugene Grauer

Surveyed MAY 31, 1979, by *[Signature]*