


T.10S., R.1E., W.M.

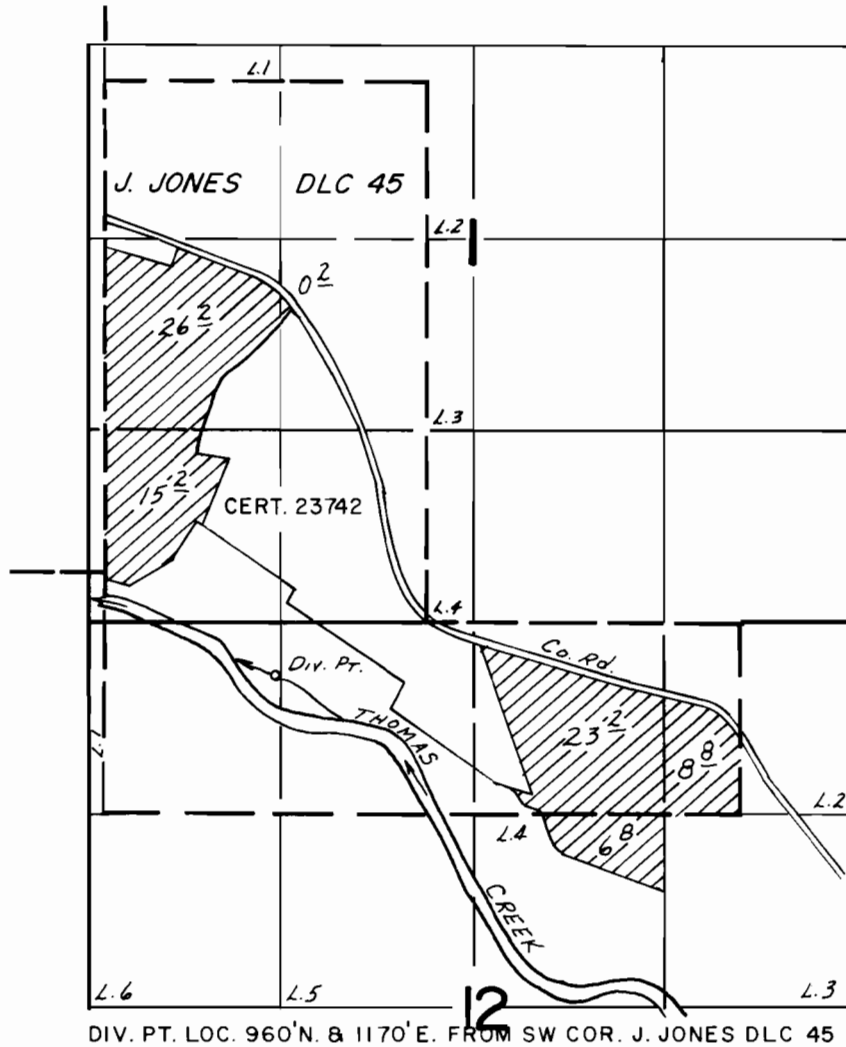

FINAL PROOF SURVEY
UNDER

Application No. 52246.. Permit No. 39321.....
IN NAME OF

.....THOMAS A. BARTLETT.....

Surveyed JUNE 9.. 1982., by L. M. TOLL.....