T. 40 & 41 S., R. 8 W., W. M.

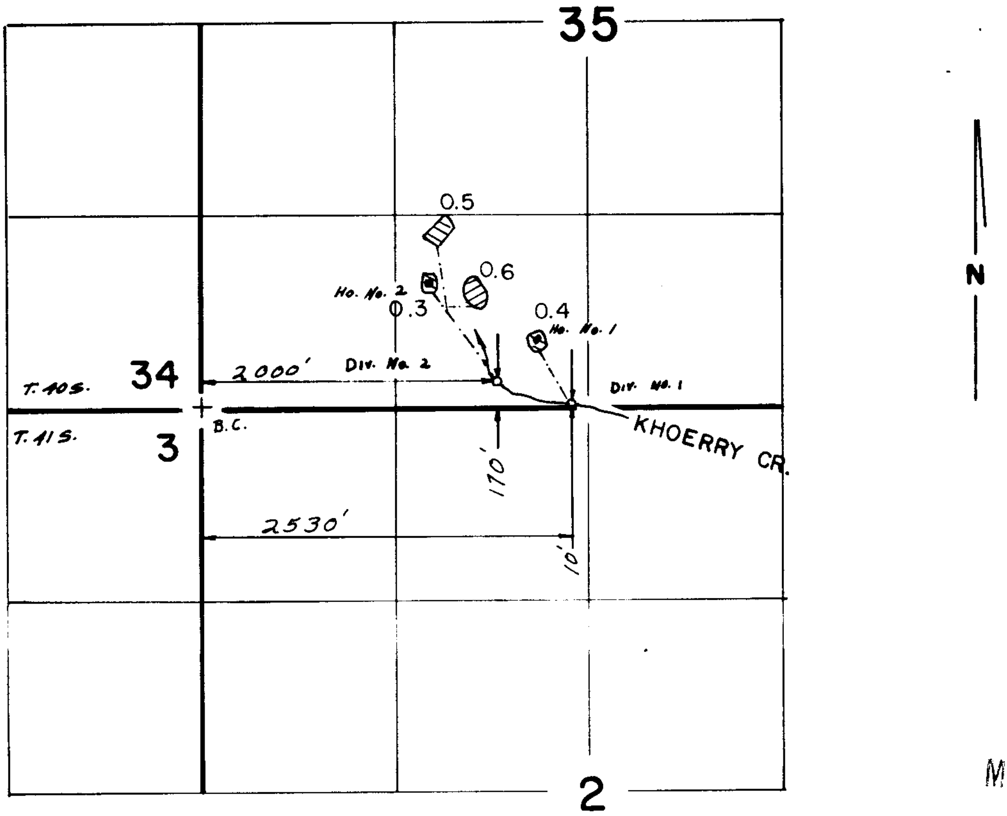

Scale: 1" = 1320'

MAY 6 1988
WM DIST. 14
GRANTS PASS, ORE.

FINAL PROOF SURVEY

UNDER

52013 39206 ▧

Application No. 62410 Permit No. 46548 ▨

IN NAME OF

LANCE E. BISSACCIA

Surveyed APR. 3 19 86, by B. S. JAMES.

ISED 12/16/87 LHN

41033-179-1892